

KANSAS

Stafford

Section 11 Township 21 Range 13W

Well No. 1 Allphine "B"


Company Westgate-Greenland

Rothgarn

NORTH

WEST

EAST

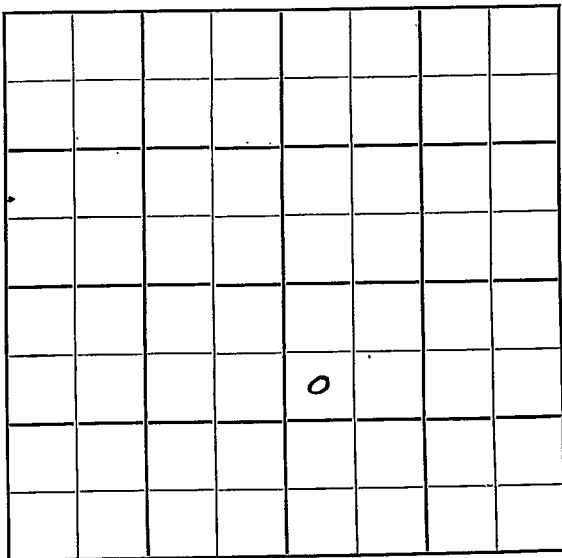

SOUTH

KANSAS

Stafford

Sec. 11 Twp. 21 R. 13W

Well No. #1 Allphine "B" Farm

Westgate-Greenland Company

Rothgarn Pool


990' Ft. from N. Line

Ft. from S. Line

Ft. from E. Line

330' Ft. from W. Line

SW NW SE

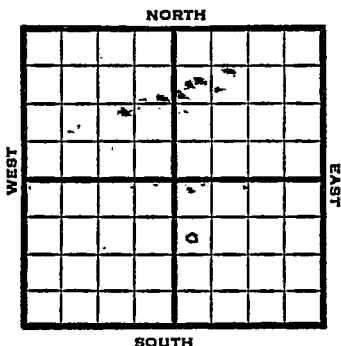

1949

Elev 1871' REPORT

4/20 8"@ 282' -
4/27 Lansing 3286'
Arb. 3546-66'
TD 3566'
5"@ 3566'

5/4 "
5/10 TD 3571'
1000 acid
PB 3559'
47 shots 3548-58
SO 1000 acid
5/18 TD 3571'
Arb. 3546'
5 @ 3566'
Aband.

ABANDONED

Map No. _____ Sec. 11 Twp. 21 R. 13W

Well No. 1 Allphine "B"

Westgate-Greenland Company

FIRST REPORT Contractor

SW NW SE

SECTION PLAT

990 Ft. from N. Line

_____ Ft. from S. Line

_____ Ft. from E. Line

330 Ft. from W. Line

		o	

Stafford County

Location _____

Rig up _____

Drilling and Remarks:

8" @ 282 ,

RECORD

Cased _____ in., _____ ft.

Sand _____

Gas _____

Oil _____

Total Depth _____

PRODUCTION

1st 24 hrs. Nat. _____

1st 24 hrs. after shot _____

Gas _____ Cu. Ft.

Dry Hole _____

Abandoned _____

Date

APR 20 1949

19

S. J. LEWIS

Scout

Map No. K82 Sec. 11 Twp. 21 R. 13W

Well No. 1 Allphine "B"

Westgate-Greenland Company

ABANDONED

Contractor

SW NW SE


E 11, 1871
SECTION PLAT

990 Ft. from N. Line

 Ft. from S. Line

 Ft. from E. Line

330 Ft. from W. Line

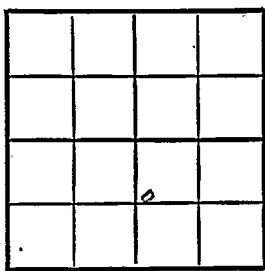

Stafford County

Location

Rig up

Drilling and Remarks:

Ce 43546
5" @ 3566

RECORD

Cased in., ft.

Sand

Gas

Oil

Total Depth 2571

PRODUCTION

1st 24 hrs. Nat.

1st 24 hrs. after shot

Gas Cu. Ft.

Dry Hole

Abandoned

Date

MAY 18 1949

19

S. J. LEWIS Scout