


Section 11 Township 21 Range 13 W

Well No. #1 McDonald

Company Atlantic

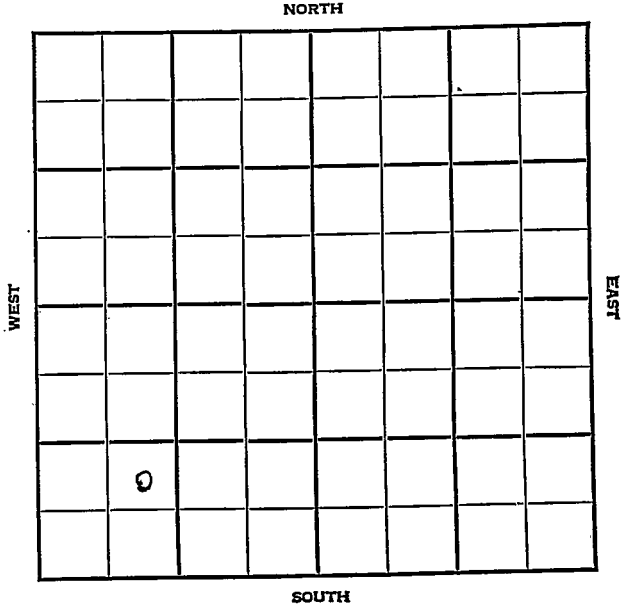



Sec. 11 Twp. 21 R. 13W

Well No. #1 McDonald Farm

Atlantic Company


Wildcat

_____ Ft. from N. Line

990' Ft. from S. Line

_____ Ft. from E. Line

990' Ft. from W. Line

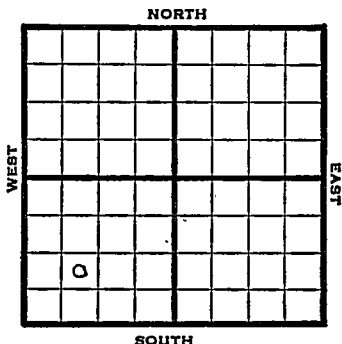

NE SW SW

1948 Eli 1872' REPORT

6/30	Location
7/8	8" @ 289' Drlg 2150'
7/14	Lansing 3280' Drlg 3370'
7/21	Arb. 3520' TD 3532' 5" @ 3420'
7/28	1000 acid swb 31 bbls oil PH
8/4	"
8/11	"
8/18	"
8/25	"
9/1	"
9/8	Pump 5 bbls oil PH - 6 hrs.
9/15	Arb. 3520' 5" @ 3520' TD 3532' 1000 acid Pump 509' Oil Pot 41° Gr. Comp COMPLETED

Map No. _____ Sec. 11 Twp. 21 R. 13W

Well No. 1 McDonald

Atlantic Company

FIRST REPORT

Contractor

NE SW SW

SECTION PLAT

_____ Ft. from N. Line

990 Ft. from S. Line

_____ Ft. from E. Line

990 Ft. from W. Line

Stafford County

Location X

Rig up _____

Drilling and Remarks:

RECORD

Cased _____ in., _____ ft.

Sand _____

Gas _____

Oil _____

Total Depth _____

PRODUCTION

1st 24 hrs. Nat. _____

1st 24 hrs. after shot _____

Gas _____ Cu. Ft.

Dry Hole _____

Abandoned _____

Date

JUN 30 1948 19

S. J. LEWIS

Scout

W A 7

CO. ~~Stafford~~ new 1869
ELEV. 1872 old
SEC. 11 TWP. 21 RGE. 13
COMPANY Atlantic NO 1

FIRST REPORT
OCT 16 57
COMPLETE

FARM McDonald
LOC. NE 1/4 Sec 11

(O.W.W.O)

Tops	
Lans 3272	
Simp 3510	
Arb. 3520	
OTD 3532	
BL 3248	
LK 3264	
Simp 3497	
Arb 3515	

GEOL. _____
CONTR. _____
POOL Rothgarn E.
SPUD Old Info. tops 5"
@ 3520⁺ was Arb Prod.
New Info. New Log tops
New Elev. 1869. PB to
Lans. perf 60H/3264-79,
24H/3299-96 20H/3304-09
16H/3313-17, 28H/3329-36

32H/3387-95, 16H/3447-51, POP & P 25
BOPD + 55% wtr (nat)

COMPLETE

CO.
LSE.
NO.
SEC.
TWP.
RGE.