

KANSAS Stafford



Sec. 11 Twp. 21 R. 13W

Well No. #3 McDonald Farm

Atlantic

Company


Rothgarn Pool (Campbell, Cont.) NORTH

990' Ft. from N. Line

 Ft. from S. Line

990' Ft. from E. Line

 Ft. from W. Line

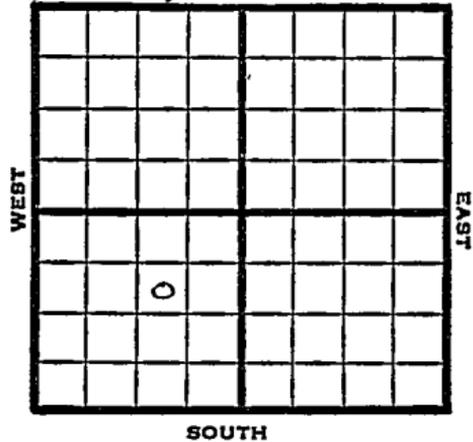

SW NE SW

1949 Elev 1873' REPORT

- 6/8 RUR
- 6/15 "
- 6/21 "
- 6/28 "
- 7/6 "
- 7/12 "
- 7/20 8"@ 270'
Drlg 1945'
- 7/27 Lansing 3272'
Drlg 3285'
- 8/3 Arb. 3539-41'
TD 3541'
5"@ 3541'
- 8/10 "
- 8/17 TD 3552
5000 acid
- 8/24 Drlg. 3616'
- 8/31 TD 3641'
- 9/7 "
- 9/14 "
- 9/21 "
- 9/28 "
- 10/5 "
- 10/12 TD 3641'
Arb. 3539'
Aband.

ABANDONED

Stafford County Kansas State

Map No. _____ Sec. 11 Twp. 21 R. 13W

Well No. 3 McDonald

Atlantic Company

Campbell Contractor

SW NE SW

FIRST REPORT
SECTION PLAT

990 Ft. from N. Line

_____ Ft. from S. Line

990 Ft. from E. Line

_____ Ft. from W. Line

							1

Rothgarn Pool

Remarks:

R U R

Date JUN 8 1949

Scout S. J. LEWIS

Map No. _____ Sec. 11 Twp. 21 R. 13W

Well No. 3 McDonald

Atlantic Company

ABANDONED Contractor

SW NE SW

E 11 1823
SECTION PLAT

990 Ft. from N. Line

_____ Ft. from S. Line

990 Ft. from E. Line

_____ Ft. from W. Line

Stafford County

RECORD

Location _____

Cased _____ in., _____ ft.

Rig up _____

Sand _____

Drilling and Remarks:

Gas _____

See 53539

Oil _____

Total Depth 3641

PRODUCTION

1st 24 hrs. Nat. _____

1st 24 hrs. after shot _____

Gas _____ Cu. Ft.

Dry Hole _____

Abandoned _____

Date

OCT 12 1949

S. J. LEWIS

19

Scout