


Section 11 Township 21 Range 13W

Well No. 2 Sipes

Company Lee Phillips

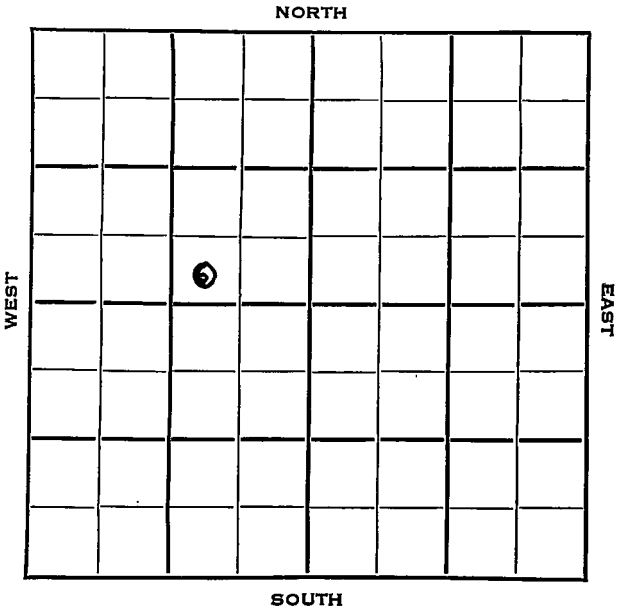

Stafford KANSAS

SEC.	TWP.	R.
11	21	13W

WELL NO. **2 Sipes** FARM

COMPANY **Lee Phillips**

CONTRACTOR


Rothgarn Pool

_____ Ft. from N. Line

330 _____ Ft. from S. Line

990 _____ Ft. from E. Line

_____ Ft. from W. Line

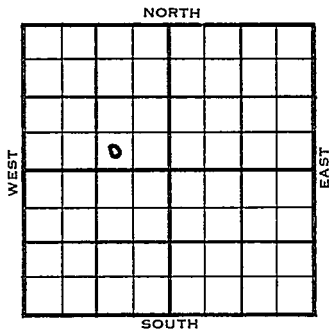

SW SE NW

	ELEVATION	REPORT
1954	1870'	

2/17 Cellar & Pits
 2/24 8" @ 508' w/400 sks
 Drlg. 2880'
 3/3 Spud 2-18-54
 D & A
 TD 3550'
 8" @ 508'
 Heeb 3135', Br. Lime 3261', Lans 3280'
 B KC 3495', Cong 3521', Simp 3544'
 TD 3550'
 D & A

ABANDONED

