


Section 11 Township 21 Range 13 W

Well No. # 1 Sipes "B"

Company Lee Phillips

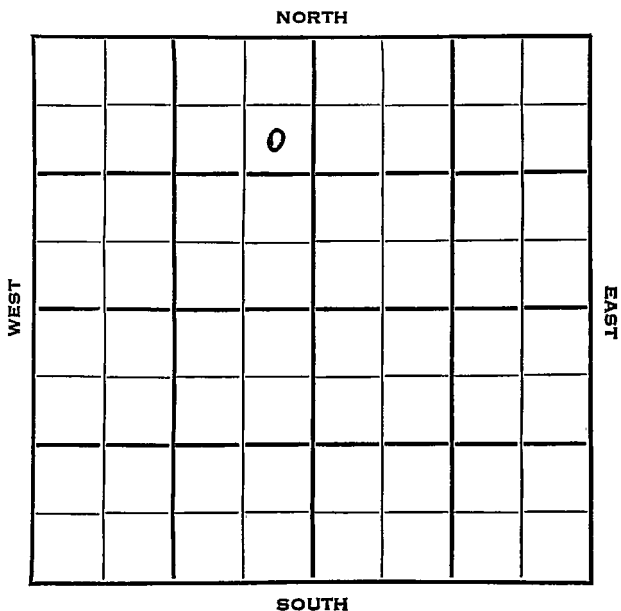

Sec. 11 Twp. 21 R. 13W

Well No. #1 Sipes "B" Farm

Lee Phillips Company

Isern Drig. Contractor

Rothgarn Pool


990 Ft. from N. Line

_____ Ft. from S. Line

330 Ft. from E. Line

_____ Ft. from W. Line

SE NE NW

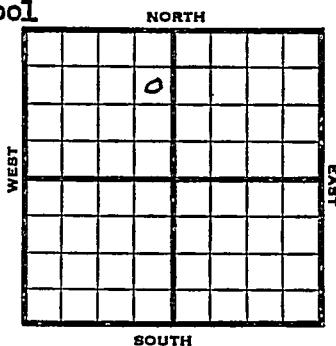

1953 Elev. 1871' REPORT

6/24 Spud 6-21-53
8" @ 557'
WOC

7/1 Spud 6-21-53
D&A
TD 3534
8" @ 557'
Heeb 3127, Br lime 3256, Lans 3274,
Arb 3528
DST 3528-34, opn 1/2 hrs., rec. 12' mud
O#
TD 3534
D&A

County Stafford State Kansas

Sec. 11 (Blk. 21) (Sur. 13W) (Rge.) Map No.

Operator Lee Phillips

Well No. 1 Farm Sipes "B"

Elev. 1871 Location SE NE NW

990 Ft. From N Line NW

330 Ft. From E Line Quarter

Ist. Report

Completion JUL 1 1953

Remarks Rothgarn Pool

Isern Drig. - Contr.

Spudding Date 6-21-53

Drig. Data D & A TD 3534

8" @ 557 Heeb. 3127 Br. lime 3256

Lans. 3274 Arb. 3528 DST 3528-34

open 1/2 hr. Rec. 12' mud 0# TD 3534

D & A