


Rice county

Section 11 Township 21 Range 7-W

Well No. #1, Willis

Company Davis-Childs

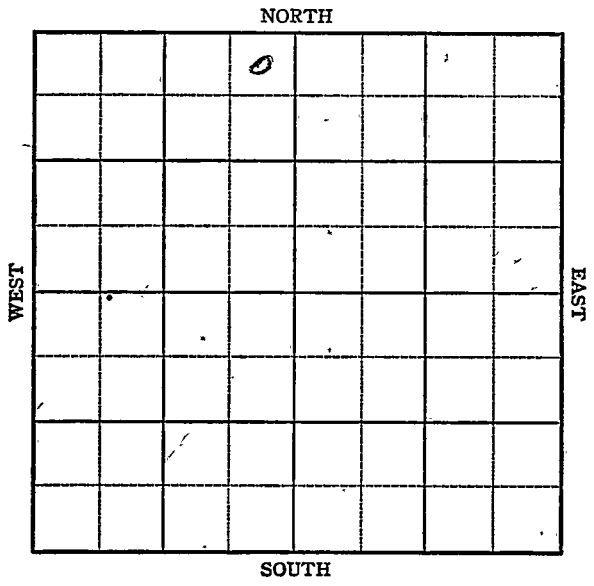

KANSAS

Rice County

Sec. 11 Twp. 21 R. 7W

Well No. 1 Willis Farm
Davis-Childs Company

Wherry Pool


NORTH

330 Ft. from N. Line

- Ft. from S. Line

330 Ft. from E. Line

Ft. from W. Line

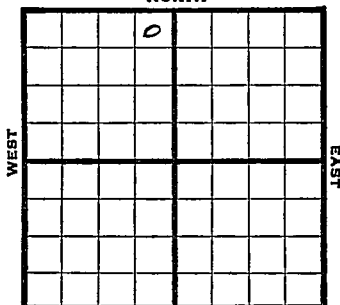

NE NW

SOUTH

1947

Elev. 1620

R E P O R T

1/2 Location
1/8 Drlg 2600'

1/15 Lams 2890
TD 3359
7" 3359
RUST

1/21 " "

1/29 TD 3372'
Cong. 3363

ABANDONED

Map No. 49 Sec. 11 Twp. 21 R. 7W


Well No. 1 Willis

Davis-Childs Company

FIRST REPORT Contractor

NE NW

SECTION PLAT

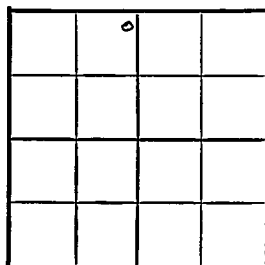

330 Ft. from N. Line

 Ft. from S. Line

330 Ft. from E. Line

 Ft. from W. Line

Rice County

Location X

Rig up

Drilling and Remarks:

RECORD

Cased in., ft.

Sand

Gas

Oil

Total Depth

PRODUCTION

1st 24 hrs. Nat.

1st 24 hrs. after shot

Gas Cu. Ft.

Dry Hole

Abandoned

Date

JAN 2 1947 19

S. J. LEWIS Scout

Map No. 49 Sec. 11 Twp. 21 R. 7W

Well No. 1 Willis

Davis-Childs Company

ABANDONED Contractor

NE NW


E11620
SECTION PLAT

330 Ft. from N. Line

 Ft. from S. Line

330 Ft. from E. Line

 Ft. from W. Line

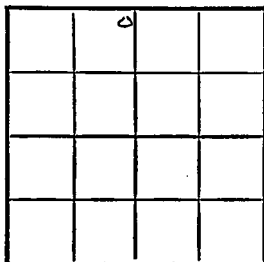

Rice County

Location

Rig up

Drilling and Remarks:

Cong 8363

RECORD

Cased in., ft.

Sand

Gas

Oil

Total Depth 8872

PRODUCTION

1st 24 hrs. Nat.

1st 24 hrs. after shot

Gas Cu. Ft.

Dry Hole

Abandoned

Date

JAN 29 1947 19 S. J. LEWIS Scout