


Section 11 Township 21 Range 12W

Well No. #1 Lanterman

Company Isern Bros.

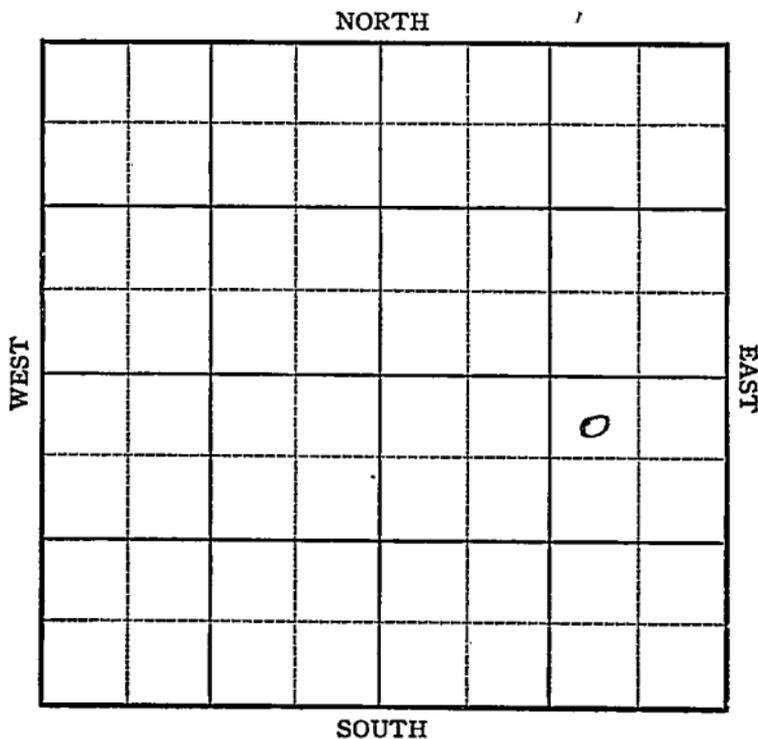

Sec. 11 Twp. 21 R. 12-W

Well No. #1 Lanterman Farm  
Isern Bros. Company


330 Ft. from N. Line

\_\_\_\_\_ Ft. from S. Line

990 Ft. from E. Line

\_\_\_\_\_ Ft. from W. Line

*Elev. 1836*

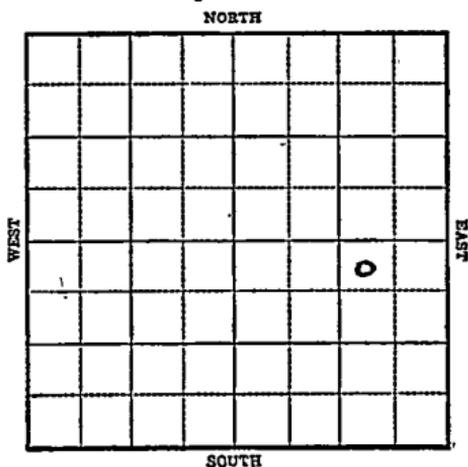

1944

R E P O R T

2/2

8" @ 290  
Anhy 595  
Drlg. 775'

2/9

Drlg. 3024

2/16

Ans 3213  
Cong 3471  
TD 3630  
3630 in Cong.

**ABANDONED**

KANSAS

Map No. 46 Sec. 11 Twp. 21 R. 12W

Well No. 1 Lanterman

Isern Bros. Company

FIRST REPORT Contractor

NW NE SE


SECTION FLAT

330 Ft. from N. Line

\_\_\_\_\_ Ft. from S. Line

9.90 Ft. from E. Line

\_\_\_\_\_ Ft. from W. Line

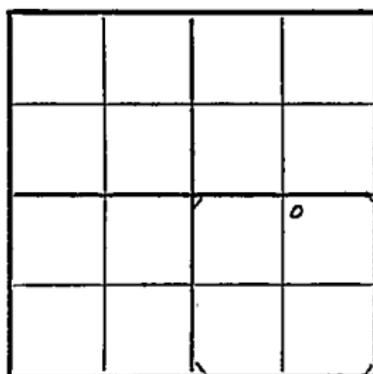

Wildcat

Location \_\_\_\_\_

Rig up \_\_\_\_\_

Drilling and Remarks:

8" - 290  
Anhy. 595  
775'

RECORD

Cased \_\_\_\_\_ in., \_\_\_\_\_ ft.

Sand \_\_\_\_\_

Gas \_\_\_\_\_

Oil \_\_\_\_\_

Total Depth \_\_\_\_\_

PRODUCTION

1st 24 hrs. Nat. \_\_\_\_\_

1st 24 hrs. after shot \_\_\_\_\_

Gas \_\_\_\_\_ Cu. Ft.

Dry Hole \_\_\_\_\_

Abandoned \_\_\_\_\_

Date

FEB 2 1944 19

S. J. LEWIS Scout

KANSAS

Map No. 46 Sec. 11 Twp. 21 R. 12W

Well No. 1 Lanterman

Isern Bros. Company

ABANDONED Contractor

NW NE SE

SECTION PLAT

330 Ft. from N. Line

\_\_\_\_\_ Ft. from S. Line

990 Ft. from E. Line

\_\_\_\_\_ Ft. from W. Line

			o

Wildcat

Location \_\_\_\_\_

Rig up \_\_\_\_\_

Drilling and Remarks:

*Loss 8212*  
*Coag 8471*  
*3630 in Coag*

RECORD

Cased \_\_\_\_\_ in., \_\_\_\_\_ ft.

Sand \_\_\_\_\_

Gas \_\_\_\_\_

Oil \_\_\_\_\_

Total Depth 3630

PRODUCTION

1st 24 hrs. Nat. \_\_\_\_\_

1st 24 hrs. after shot \_\_\_\_\_

Gas \_\_\_\_\_ Cu. Ft.

Dry Hole \_\_\_\_\_

Abandoned \_\_\_\_\_

Date

FEB 16 1944 19

S. J. LEWIS Scout