

KANSAS

Sec. 11 Twp. 21 R. 12W

Well No. 1 Wolf Farm

Virginia Drlg. etal Company

Mueller Pool

Ft. from N. Line


330

Ft. from S. Line

Ft. from E. Line

330

Ft. from W. Line

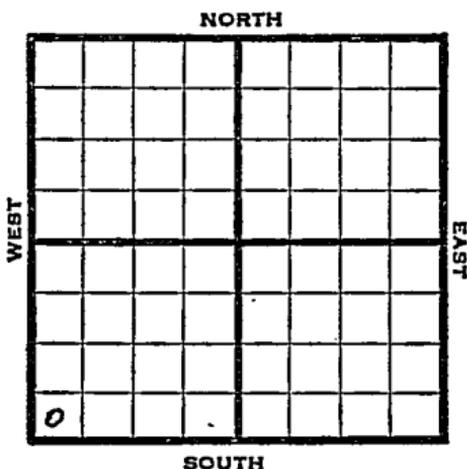

SW/C

1947 Elev. 1838' REPORT

5/7	8" @ 283' WOC
5/13	Drlg 2725'
5/20	Arb 3503 5" @ 3506' TD 3506' RUST
5/27	" "
6/3	" "
6/10	" "
6/17	" "
6/24	TD 3523' 15 qts. 3513-23'
7/1	" "
7/8	TD 3551' 350' oil 36 hrs.
7/16	" "

VER

1947

7/22 TD 3579
1300' Water
PB

7/29 "

8/6 "

8/13 Arb 3503'
5" @ 3506'
T.D. 3579'
Abandoned

ABANDONED

