

TYPE

AFFIDAVIT OF COMPLETION FORM

ACO-1 WELL HISTORY

Compt.

SIDE ONE

36-21-12W

Two (2) copies of this form shall be filed with the Kansas Corporation Commission, 200 Colorado Derby Building, Wichita, Kansas 67202, within thirty (30) days after the completion of a well, regardless of how the well was completed.

Attach separate letter of request if the information is to be held confidential. If confidential, only file one copy. Information on Side One will be of public record and Side Two will then be held confidential.

Applications must be made on dual completion, commingling, salt water disposal, injection and temporarily abandoned wells.

Attach one copy only wireline logs (i.e. electrical log, sonic log, gamma ray neutron log, etc.). (Rules 82-2-105 & 82-2-125) KCC# (316) 263-3238.


LICENSE # 5339 EXPIRATION DATE 6-30-84
OPERATOR Bergman Oil Company API NO. 15-185-21,807
ADDRESS 520 Union Center COUNTY Stafford
Wichita, Kansas 67202 FIELD Sand Hills

** CONTACT PERSON Harold I. Bergman PROD. FORMATION Arbuckle
PHONE 316-267-5291

PURCHASER Getty Crude Gathering, Inc. LEASE Mellies
ADDRESS P.O. Box 3000 WELL NO. 4
Tulsa, OK 74102 WELL LOCATION N/2 N/2 NE

DRILLING CONTRACTOR Rains & Williamson Oil Co., Inc. 330' Ft. from North Line and
ADDRESS 435 Page Court, 220 W. Douglas 1320 Ft. from East Line of
Wichita, Kansas 67202 the NE (Qtr.) SEC 36 TWP 21S RGE 12

PLUGGING CONTRACTOR ADDRESS

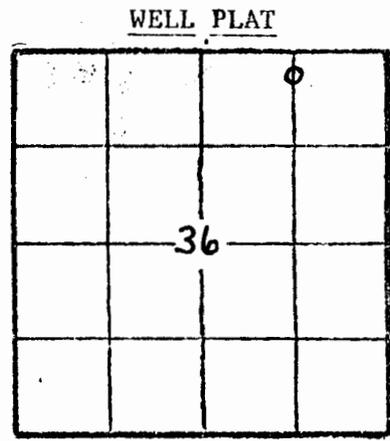

(Office Use Only)
KCC
KGS
SWD/REP
PLG.

TOTAL DEPTH 3572' PBDT
SPUD DATE 6-8-83 DATE COMPLETED 7-11-83
ELEV: GR 1788 DF KB 1797

DRILLED WITH (CABLE) (ROTARY) (AIR) TOOLS.
DOCKET NO. OF DISPOSAL OR REPRESSURING WELL BEING USED TO DISPOSE OF WATER FROM THIS LEASE

Amount of surface pipe set and cemented 261' DV Tool Used?

THIS AFFIDAVIT APPLIES TO: (Circle ONE) - Oil, Gas, Shut-in Gas, Dry, Disposal, Injection, Temporarily Abandoned, OWWO. Other

ALL REQUIREMENTS OF THE STATUTES, RULES AND REGULATIONS PROMULGATED TO REGULATE THE OIL AND GAS INDUSTRY HAVE BEEN FULLY COMPLIED WITH.

AUG 10 1983

A F F I D A V I T

Harold I. Bergman, being of lawful age, hereby certifies that:

I am the Affiant, and I am familiar with the contents of the foregoing Affidavit. The statements and allegations contained therein are true and correct.

Handwritten signature of Harold I. Bergman

State Geological Survey WICHITA BRANCH