

Section 12 Township 21 Range 13WWell No. #1 AllphineCompany Plains Exploration Co.

NORTH

|  |  |  |  |  |  |  |  |
|--|--|--|--|--|--|--|--|
|  |  |  |  |  |  |  |  |
|  |  |  |  |  |  |  |  |
WEST

EAST

SOUTH

$$\begin{array}{r} 3540 \\ 1862 \\ \hline 1678 \\ - \end{array}$$

30W Ne SE

Stafford

KANSAS

Sec. 12 Twp. 21 R. 13 W

Well No. # 1 Allphine Farm

Plains Exploration Co. Company

Sterling Contractor


990 Ft. from N. Line

           Ft. from S. Line

330 Ft. from E. Line

           Ft. from W. Line

SE NE SW

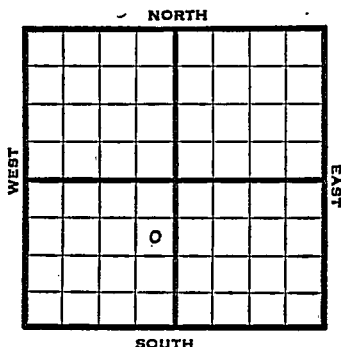

1951

Elev. 1861' REPORT

11/7

RUR

12/12

Spud 11-7-51

D&A TD 3569

8" @ 291 Anhy 715

Br line 3262 Lans. 3276

Arb. 3538 TD 3540

5" @ 3540 DD 3554 500 A

S/3 bphh S/3 go 11 gw 1 hr.

DD 3559 2000 A S/3 bf DD 3561

8 go 10 gw 1 hr. DD 3569

9 go 9 1/2 gwph FU 150' wtr

50' oil 10 hr. DD 3586 81 gw 90

go 2 hr. 97 gw 10 go, 2 hr.

D&A

**ABANDONED**

County Stafford State Kansas  
 Sec. 12 (Blk. Twp.) 21 (Sur. Rge.) 13W Map No.  
 Operator Plains Exploration Co.  
 Well No. 1 Farm Allphine  
 Elev. \_\_\_\_\_ Location SE NE SW

|  |  |  |  |  |  |  |  |  |  |
|--|--|--|--|--|--|--|--|--|--|
|  |  |  |  |  |  |  |  |  |  |
|  |  |  |  |  |  |  |  |  |  |
**FIRST REPORT**

990 Ft. From N Line SW  
330 Ft. From E Line Quarter

Ist. Report NOV 7 1951

Completion \_\_\_\_\_

Remarks \_\_\_\_\_

Sterling - Contr.


Spudding Date \_\_\_\_\_

Drlg. Data \_\_\_\_\_

RUR

**J. E. TYRA**

County Stafford State Kansas  
 Sec. 12 (Blk. 21) (Sur. 13W) Map No. 13W  
 Operator Plains Exploration  
 Well No. 1 Farm Allphine  
 Elev. 1861 Location SE NE SW

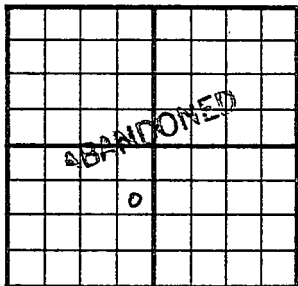

990 Ft. From N Line SW  
330 Ft. From E Line Quarter  
 Ist. Report DEC 1 2 1951  
 Completion DEC 1 2 1951  
 Remarks Sterling Drlg. - Contr.  
 Spudding Date 11-7-51

Drlg. Data D & A TD 3569

8" @ 291 Anhy 715 Br. lime 3262

Lans. 3276 Arb. 3538 TD 3540

5" @ 3540 DD 3554 500 A S/ 3 boph

S/ 3 go 11 gw 1 hr. DD 3559

2000 A S/ 3 bf. DD 3561 8 go 10 gw

1 hr. DD 3569 9 go 9½ gwph FU 150' wtr

50' oil 10 hr. DD 3586 81 gw 90' go

2 hr. 97 gw 10 go 2 hr.

D & A

J. E. TYRA