

Rice


KANSAS

SECTION 12 TOWNSHIP 21 RANGE 7 W

WELL NO. #1 Nelson

COMPANY H. C. Bennett

NORTH

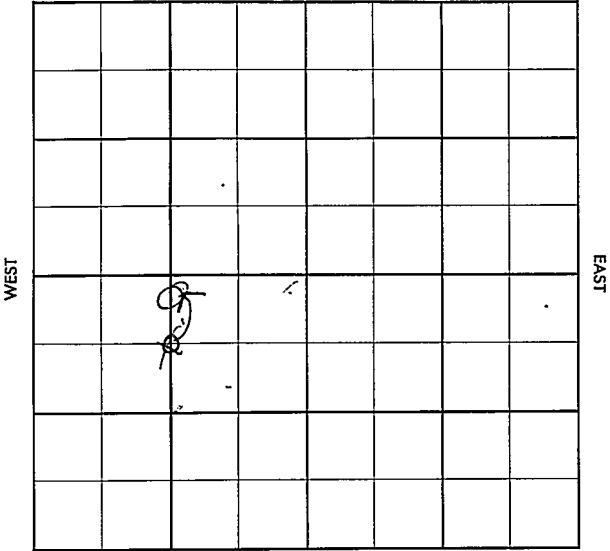

SOUTH

Rice

KANSAS

SEC.	TWP.	R.
12	21	7W

WELL NO.

#1 Nelson

FARM

COMPANY

H.C. Bennett

CONTRACTOR

Salina Drlg.

Welch- Bornholdt


NORTH

Ft. from N. Line

Ft. from S. Line

Ft. from E. Line

Ft. from W. Line

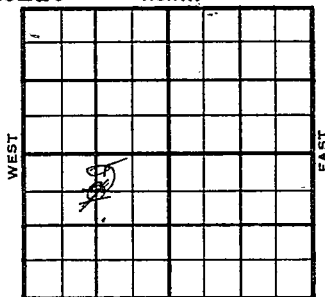C N $\frac{1}{2}$ SW C N $\frac{1}{2}$ N $\frac{1}{2}$ SW

	ELEVATION	REPORT
1955	1633'	
12-21	Comm. 12-18-55 Drlg. 1000	
<u>1956</u>		
5-16	8 5/8" @ 175 8 1/2 5 1/2" @ 3401 CO to 3404 DD 3409 DD 3443 PB 3401, 15/ 3398-3401, frac, S/ 6 bopd, 6 bw. Comp. 2 bopd, 2 bw TD 3404' H. 2707', Tr. 2723', Dg. Sd. 2726', L. 2932', C. Shly. 3390', Ch. Cong 3400'	

COMPLETED


Elev. _____

Sec. 12Twp. 21Rge. 7WCompany H. C. BennettFarm Name NelsonNo. 1

TOPS

DEPTH

LOG

DATUM

Loc. in Sec. _____

Anh. _____

Tp. _____

H. _____

Tr. _____

Dg. _____

Bl. _____

L. _____

K.C. _____

B.K.C. _____

Ce. _____

C. _____

M. _____

M. _____

K. _____

Mz. _____

Mq. _____

V. _____

S. _____

S. _____

A. _____

R. _____

P.C. _____

G. _____

T.D. _____

G N $\frac{1}{2}$ SW

Geol. _____

Contr. _____

Salina Drlg.

Pool _____

Welch-Bornholdt

FIRST REPORT

DEC 21 1955

Date Comm. 12-18-55drlg. 1000

Co.

Lse.

No.

Sec.

T.

R.

CORRECTION

FORM 513 REV. SUNRAY

County Rice Elev. _____
 Sec. 12 Twp. 21 Rge. 7W
 Company H. C. Bennett
 Farm Name Nelson No. 1

TOPS DEPTH LOG DATUM

Anh.			
Tr.			
H.			
Tr.			
Dg.			
Bl.			
L.			
K.C.			
B.K.C.			
Ce.			
C.			
M.			
M.			
K.			
Mz.			
Mq.			
V.			
S.			
S.			
A.			
R.			
Pe.			
G.			
T.D.			

Loc. in Sec. C N $\frac{1}{2}$ N $\frac{1}{2}$ SW

Geol. _____

Contr. _____

Pool _____

CORRECTION

Date Comm. _____

MAY 16 1956

Reported C N $\frac{1}{2}$ SW

Co.

Lse.

No.

Sec.

T.

R.

County Rice Elev. 1633
 Sec. 12 Twp. 21 Rge. 7W
 Company H. C. Bennett
 Farm Name Nelson No. 1

TOPS	DEPTH	LOG	DATUM	Loc. in Sec.
Anh.				C N $\frac{1}{2}$ N $\frac{1}{2}$ SW
Tr.				
H.	2707			
Tr.	2723			
Dg. sd.	2726			
Bl.				
L.	2932		1299	Geol.
K.C.				Contr.
B.K.C.				
Ce.				
C. shly	3390		1757	Salina Drlg
M. Ch. Gng	3400		1767	
M.				Pool
K.				Welch-Bornholdt
Mz.				
Me.				
V.				
S.				
S.				
A.				
R.				
Pe.				
G.				
TD.	3404			

COMPLETE

Date Comm. 12-18-55 MAY 1 6 1956

8 5/8" @ 175 5 1/2" @ 3401 CO to 3404

DD 3409 DD 3443 PB 3401 15/ 3398-3401

frac S/ 6 bopd 6 bw

Comp. 2 bopd 2 bw