
FORM 51 5M 4-41 PETROL KANSAS Rice

Section 12 Township 21 Range 7W

Well No. #3 Nelson

Company Mid plains

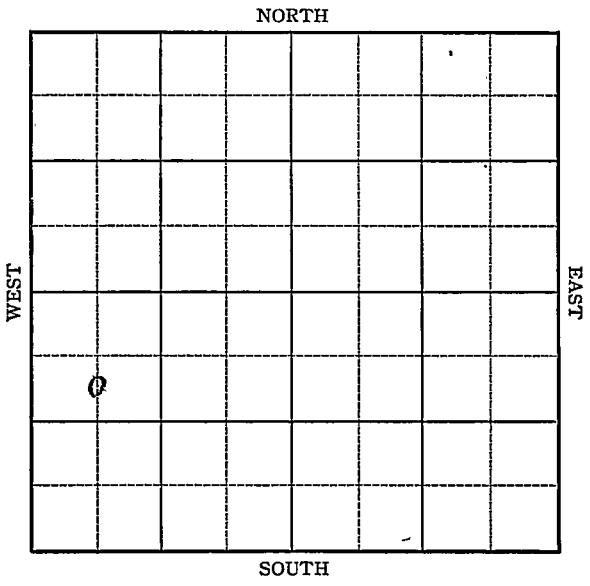

FORM 252-A
5M 10-41 PETROL

KANSAS

Rice

Sec. 12 Twp. 21 R. 7-W

Well No. #3 Nelson Farm

Mid-Plains Company.

(Wherry)


990 Ft. from N. Line

_____ Ft. from S. Line

_____ Ft. from E. Line

660 Ft. from W. Line

Elev. 1618

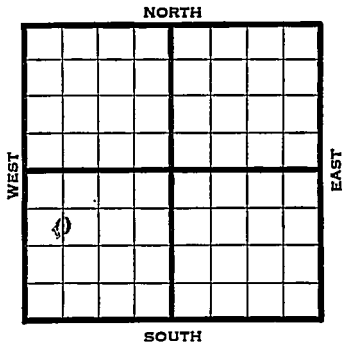


| 1941 | REPORT |
|---|---|
| 11/5 | Surface hole. |
| 11/13 | 10" - 130' Drlg. 2610' |
| 11/20 | Chat. 3391' 7" - 3397' T.D. |
| | RUST. |
| 11/28 | T.D. 3403' H.F.O. in 1 hour. |
| | |
| 12/3 | Chat. 3391' |
| | 7" - 3397' |
| | T.D. 3403' |
| | Potential 40 bbls., pump. |
| | 37.4 Gravity |
| | |
| | COMPLETED |

Form 26 200 Bks. 5-41 McW. Rice KANSAS

Map No. K-49 Sec. 12 Twp. 21 R. 7W

Well No. 3 Nelson

Mid Plains Company

FIRST REPORT Contractor

C SL NW SW


990 Ft. from N. Line

____ Ft. from S. Line

____ Ft. from E. Line

660 Ft. from W. Line

SECTION PLAT

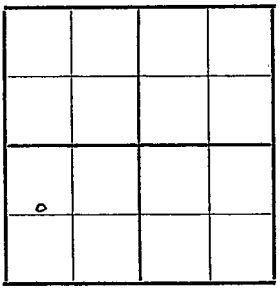

WHERRY POOL

Location

Rig up

Drilling and Remarks:

Surface Hole

RECORD

Cased ____ in., ____ ft.

Sand

Gas

Oil

Total Depth

PRODUCTION

1st 24 hrs. Nat.

1st 24 hrs. after shot

Gas ____ Cu. Ft.

Dry Hole

Abandoned

Date

NOV 5 1941 19

S. J. LEWIS Scout

Form 26 200 Bks. 5-41 McW.

Rice KANSAS

Map No. 49 Sec. 12 Twp. 21 R. 7W

Well No. 3 Nelson

Mid Plains Company

Contractor

COMPLETED

C SL NW SW


990 Ft. from N. Line

Ft. from S. Line

Ft. from E. Line

660 Ft. from W. Line

SECTION PLAT

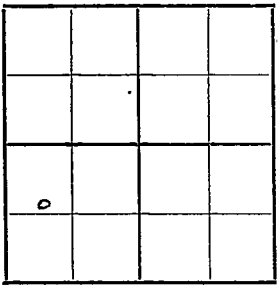

WHERRY POOL

Location

Rig up

Drilling and Remarks:

Okla 3391

7" @ 3397

Pump 40 BO

37 # Gr

RECORD

Cased in., ft.

Sand

Gas

Oil

Total Depth 3403

PRODUCTION

1st 24 hrs. Nat.

1st 24 hrs. after shot

Gas Cu. Ft.

Dry Hole

Abandoned

Date

DEC 3 1941 19 S. J. LEWIS Scout