


Rice

Section 12 Township 21 Range 7-W

Well No. #1 Pallister

Company Carl Hipple Oil

(Wherry)

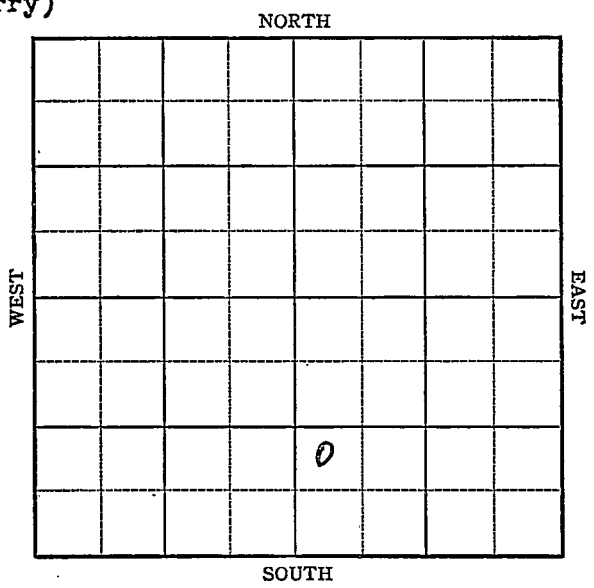

KANSAS

Rice

Sec. 12 Twp. 21 R. 7-W

Well No. #1 Pallister Farm

Carl Hipple Oil Company

(Wherry)


 Ft. from N. Line

990 Ft. from S. Line

 Ft. from E. Line

330 Ft. from W. Line

Elev. 1632

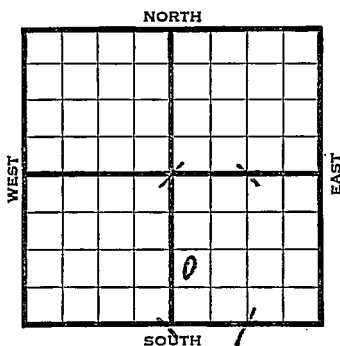

1941	REPORT
12/10	10" - 106'
	WOC
12/18	Drilg. 1703
12/24	Drilg. 3206'
12/31	Cong. 3429' 7" - 3424'
	20' of 5" liner 3429'
	T.D. 3441' H.F.O. in 2 hours.
1942	
1/7	" " " "
1/14	Cong. 3429'
	7" - 3424'
	T.D. 3441'
	20' of 5" liner.
	Pump 225 oil plus 8% water.
	36. Gravity
	COMPLETED


Rice

KANSAS

Map No. 49 Sec. 12 Twp. 21 R. 7WWell No. 1 PallisterCarl Hipple Oil CompanyFIRST REPORT Contractor

NW SW SE

SECTION PLAT

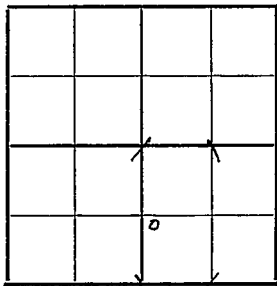 Ft. from N. Line990 Ft. from S. Line Ft. from E. Line330 Ft. from W. Line

WHERRY POOL

Location Rig up

Drilling and Remarks:

10" - 106'Waiting on
cement to set;

RECORD

Cased in., ft.Sand Gas Oil Total Depth

PRODUCTION

1st 24 hrs. Nat. 1st 24 hrs. after shot Gas Cu. Ft.Dry Hole Abandoned

Date

DEC 10 1941 19 S. J. LEWIS Scout

Rice

KANSAS

Map No. 49 Sec. 12 Twp. 21 R. 7WWell No. 1 PallisterCarl Hipple Oil CompanyCOMPLETED Contractor

NW SW SE

SECTION PLAT

 Ft. from N. Line990 Ft. from S. Line Ft. from E. Line330 Ft. from W. Line

WHERRY POOL

Location Rig up

Drilling and Remarks:

Comp 3428
750 3424
20' of 5" liner
Pump. 225 oil
+ 8% Water.
360 Gr

RECORD

Cased in., ft.Sand Gas Oil Total Depth 3441

PRODUCTION

1st 24 hrs. Nat. 1st 24 hrs. after shot Gas Cu. Ft.Dry Hole Abandoned

Date

JAN 14 1942 19S. J. LEWIS Scout