

KANSAS


FORM 51 5M 4-41 PETROL

Rice

Section 12 Township 21 Range 7-11

Well No. 1 Pallister

Company Kirk D. Holland

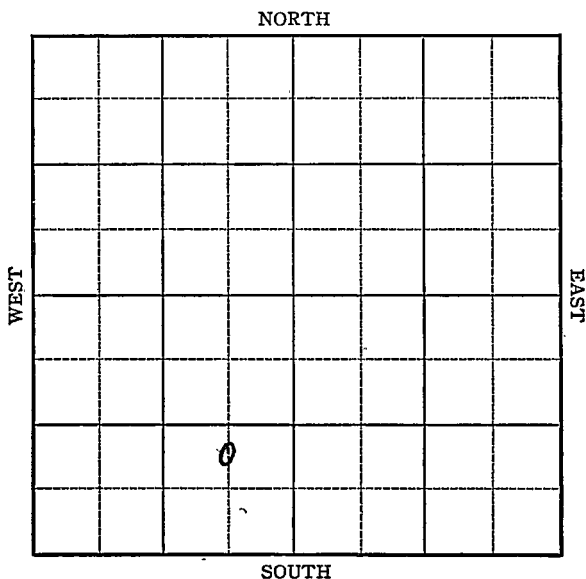

KANSAS


Rice

Sec. 12 Twp. 21 R. 7-WWell No. #1 Pallister FarmKirk D. Holland Company

(Wherry)

 Ft. from N. Line990 Ft. from S. Line660 Ft. from E. Line Ft. from W. Line

Elev. 1621

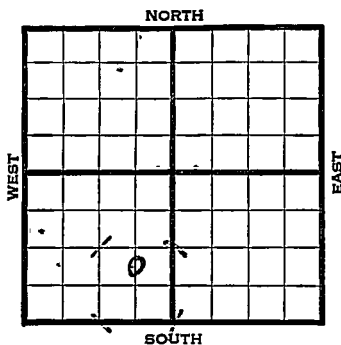

1941

REPORT

7/9 Rotary.

7/17 8" - 79' Drlg. 2600'

7/24 Lansing 2895 Cong 3295 5" @ 3314
TD Rust7/31 Cong 3416(Corrected) 5" @ 3414
TD 3430 2600' oil & 200' water
24 hrs.

8/7 " " " " " "

~~8/15 XXXXX XXXXX~~~~X5"XXX3402X~~~~6000XXX333X~~~~T30XXX412'~~~~XXXXXX XXX XXXXX XXXXX XXXXX~~~~333XXX30X~~**OVER**

OVER

1941

8/13

Lans. 2895'

Congl. 3416'

~~52x~~

5" 3414'

T.D. 3430'

Pump. Pot. 240 oil-25 water
in 24 hrs.

Grav. 36.8

COMPLETED

Map No. _____ Sec. 12 Twp. 21 R. 7WWell No. 1 Pallister_____Kirk D. Holland_____
Company_____
Contractor


FIRST REPORT

C N L SE SW

Ft. from N. Line990 Ft. from S. Line660 Ft. from E. Line_____
Ft. from W. Line

WHERRY POOL

SECTION PLAT

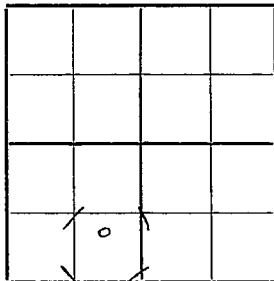

Location _____

Rig up _____

Drilling and Remarks:
Rotary

RECORD

Cased _____ in., _____ ft.

Sand _____

Gas _____

Oil _____

Total Depth _____

PRODUCTION

1st 24 hrs. Nat. _____

1st 24 hrs. after shot _____

Gas _____ Cu. Ft.

Dry Hole _____

Abandoned _____

Date

JUL 9 194119S. J. LEWIS Scout

Misc. Small Maps

Cards

Tracing

France Map

Scarborough Map

Moody Map

Geological Dept

Moody Map

KANSAS

Form 26 200 Bks. 5-41 McW. Rice

Map No. 49 Sec. 12 Twp. 21 R. 7W

Well No. 1 Pallister


Kirk D. Holland

Company

Contractor

C N L NE SW

SECTION PLAT

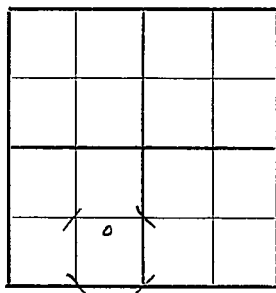

Ft. from N. Line

990 Ft. from S. Line

660 Ft. from E. Line

Ft. from W. Line

WHERRY POOL

Location

Rig up

Drilling and Remarks:

Lans 2895

Congl. 3295

Congl. 3416

5" 3414

Pump Pot 240 oil

25 wab

42 hrs

COMPLETED

RECORD

Cased _____ in., _____ ft.

Sand _____

Gas _____

Oil _____

Total Depth 3430

PRODUCTION

1st 24 hrs. Nat. _____

1st 24 hrs. after shot _____

Gas _____ Cu. Ft.

Dry Hole _____

Abandoned _____

Date

AUG 13 1941

19

S. J. LEWIS

Scout

Misc Small Maps
 Cards
 Tracing
 France Map
 Scarborough Map
 Moody Map
 Geological Dept.
 Moody Flat Book