


KANSAS

Price county.

Section 12 Township 21 Range 7W

Well No. #1. Pallister

Company Grest Western Oil

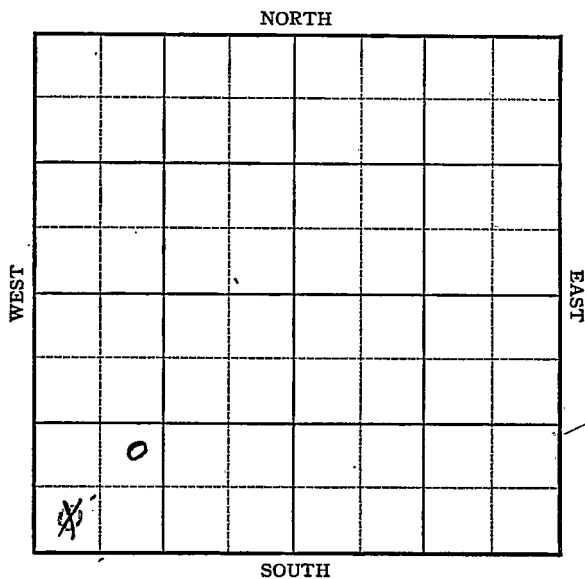

KANSAS

Rice County



Sec. 12 Twp. 21 R. 7W

Well No. #1 Pallister Farm

Great Western Oil Company

Wherry

Ft. from N. Line

990

330


Ft. from S. Line

Ft. from E. Line

990

330

Ft. from W. Line

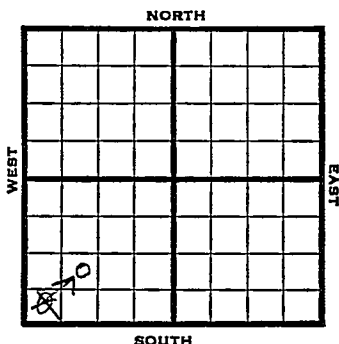

SW 1/4 NE 5W 5N

1946

Elev. 1609

REPORT

3/20

Location

3/28

"

4/4

10" @ 120
Drlg. 2050

4/10

Lans 2876
Cong 3395
TD 3396-5" @ 3395 RUST

4/11

" " "

4/23

TD 3398-1500' W 100' oil

5/1

Lans 2876
Cong 3395
24 shots 3369-3374
TD 3398'

ABANDONED

KANSAS

Kansas Pool Name WherryMap No. 219 Sec. 12 Twp. 21 R. 7WWell No. 1 PallisterGreat Western Oil

Company

FIRST REPORT

Contractor

SW/c

SECTION PLAT

0			

Ft. from N. Line

330

Ft. from S. Line

Ft. from E. Line

330

Ft. from W. Line

Rice CountyLocation X

Rig up

Drilling and Remarks:

RECORD

Cased _____ in., _____ ft.

Sand _____

Gas _____

Oil _____

Total Depth _____

PRODUCTION

1st 24 hrs. Nat. _____

1st 24 hrs. after shot _____

Gas _____ Cu. Ft.

Dry Hole _____

Abandoned _____

Date

MAR 20 1946 19S. J. LEWIS

Scout

KANSAS Kansas Pool Name Wherry
 Map No. 49 Sec. 12 Twp. 21 R. 7W
 Well No. 1 Pallister

Great Western Oil Company

CORRECTION

Contractor

NE SW SW

SECTION PLAT

 Ft. from N. Line

990 Ft. from S. Line

 Ft. from E. Line

990 Ft. from W. Line

Rice County

Location

Rig up

Drilling and Remarks:

Reported .

SW/c

RECORD

Cased in., ft.

Sand

Gas

Oil

Total Depth

PRODUCTION

1st 24 hrs. Nat.

1st 24 hrs. after shot

Gas Cu. Ft.

Dry Hole

Abandoned

Date

APR 3 1946

19

S. J. LEWIS

Scout

KANSAS Kansas Pool Name WherryMap No. 44 Sec. 12 Twp. 21 R. 7WWell No. 1 PallisterGreat Western Oil Company

ABANDONED

Contractor

NE SW SW

E. 1609
SECTION PLAT

 Ft. from N. Line990 Ft. from S. Line Ft. from E. Line990 Ft. from W. LineRice CountyLocation Rig up

Drilling and Remarks:

Lease 2876Comp 33852 1/2 hrs to 3369-74

RECORD

Cased in., ft.Sand Gas Oil Total Depth 3398

PRODUCTION

1st 24 hrs. Nat. 1st 24 hrs. after shot Gas Cu. Ft.Dry Hole Abandoned

Date

MAY 1 1946

19

S. J. LEWIS Scout