

Stafford


FORM 51 IOM 12-46 PETROL

KANSAS

Section 12 Township 21 Range 12W

Well No. 1 Schrepel

Company Sohio

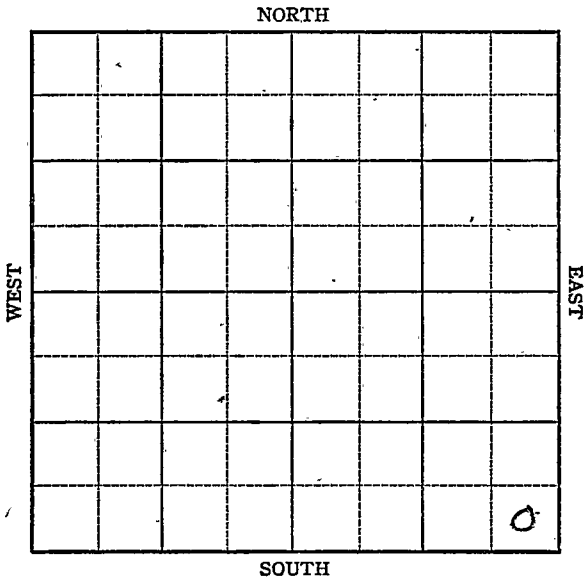

O.W.W.O.

12- KANSAS

Stafford
21

12-W



Sec. _____ Twp. _____ R. _____

Well No. #1 Schrepel _____ Farm _____

Sohio _____ Company

Mueller

_____ Ft. from N. Line

330

_____ Ft. from S. Line


330

_____ Ft. from E. Line

_____ Ft. from W. Line

SE/C

O.W.W.O.

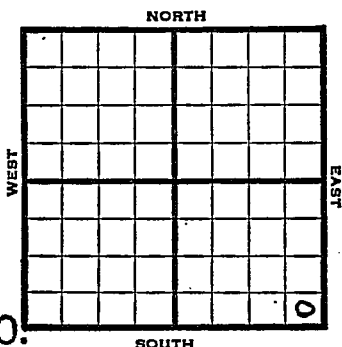

1947

Elec. 1829'

R E P O R T

6/11 R U R

6/17 8" @ 531'
Dr1g. 3120'

6/24 Arbuckle 3480'
TD 3515'
5" @ 3482'
RUST

7/1 "

7/8 TD 3515'

7/16 "

7/23 Arb. 3480'
5" @ 3482'
Pump 363' Pot.
Gr. 40
T.D. 3515'
Complete

COMPLETED

O.W.W.O.

OVER

1950

O.W.W.O.

7/12

Lans 3184

Simp 3436

Arb 3480

OTD 3515

PB 3443

DP to 3515

S/112 bo $3\frac{1}{2}$ hr

FU 1500' in $1\frac{1}{2}$ hr

Comp 114 bopd

Completed

FIRST REPORT
g
COMPLETED

Map No. _____ Sec. 12 Twp. 21 R. 12W

Well No. 1 Schrepel


Sohio Company

FIRST REPORT

Contractor _____

SE/C

SECTION PLAT

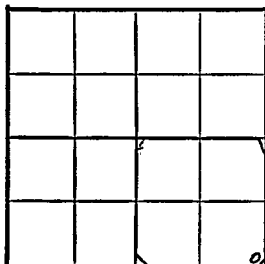

_____ Ft. from N. Line

330 Ft. from S. Line

330 Ft. from E. Line

_____ Ft. from W. Line

Stafford County

Location _____

Rig up _____

Drilling and Remarks:

R U R

RECORD

Cased _____ in., _____ ft.

Sand _____

Gas _____

Oil _____

Total Depth _____

PRODUCTION

1st 24 hrs. Nat. _____

1st 24 hrs. after shot _____

Gas _____ Cu. Ft.

Dry Hole _____

Abandoned _____

Date

JUN 1 1 1947

19

S. J. LEWIS

Scout

Map No. 46 Sec. 12 Twp. 21 R. 12W

Well No. 1 Schrepel

Sohio Company

COMPLETE

Contractor

SE/C

E11828


SECTION PLAT

 Ft. from N. Line

330 Ft. from S. Line

330 Ft. from E. Line

 Ft. from W. Line

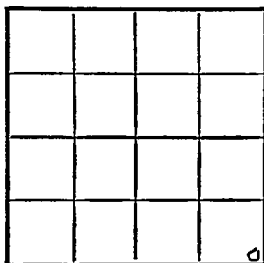

Stafford County

Location

Rig up

Drilling and Remarks:

Cr X 3480

5103482

Ping 363 BX

40 c/g

RECORD

Cased in, ft.

Sand

Gas

Oil

Total Depth *8515'*

PRODUCTION

1st 24 hrs. Nat.

1st 24 hrs. after shot

Gas Cu. Ft.

Dry Hole

Abandoned

Date

JUL 23 1947 19

S. J. LEWIS Scout

Kansas

Map No. _____ Sec. 12 Twp. 21 R. 12WWell No. 1 Schnepel

_____ Sohio _____ Company

_____ Contractor


SE SE SE

E1. 1829
SECTION PLAT

_____ Ft. from N. Line

330 Ft. from S. Line330 Ft. from E. Line

_____ Ft. from W. Line

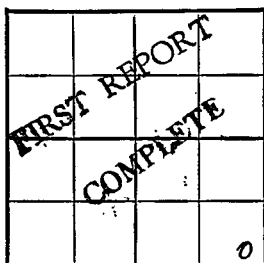

Stafford County

Location _____

Rig up _____

Drilling and Remarks:

Lans. 3184

Simp. 3436

Arb. 3480

OTD 3515

PB 3443

DP to 3515

s/ 112 bo $3\frac{1}{2}$ hr.FU 1500' in $1\frac{1}{2}$ hr.
Date Comp. 114 bopd

RECORD

Cased _____ in., _____ ft.

Sand _____

Gas _____

Oil _____

Total Depth _____

PRODUCTION

1st 24 hrs. Nat. _____

1st 24 hrs. after shot _____

Gas _____ Cu. Ft.

Dry Hole _____

Abandoned _____

JUL 12 1950 19

J. L. TYRA Scout