


Section 12 Township 21 Range 12-W

Well No. 2 Schrepel

Company Sohio

Mueller Pool NORTH

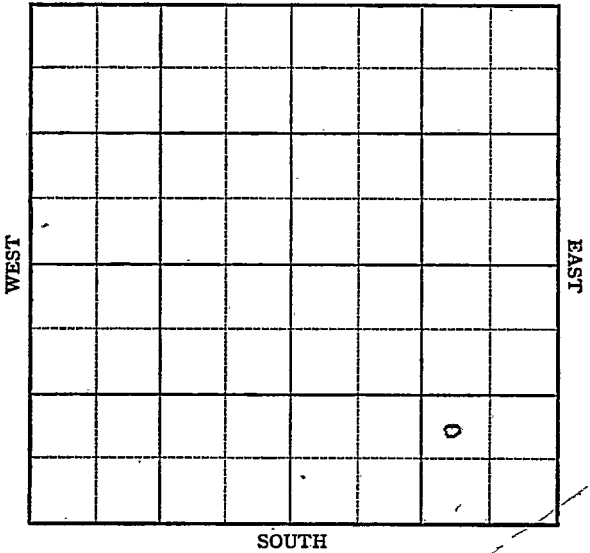

Sec. 12 Twp. 21 R. 12-W

Well No. # 2 Schrepel Farm

Sohio Company


Mueller Pool

_____ Ft. from N. Line

990 _____ Ft. from S. Line

990 _____ Ft. from E. Line

_____ Ft. from W. Line

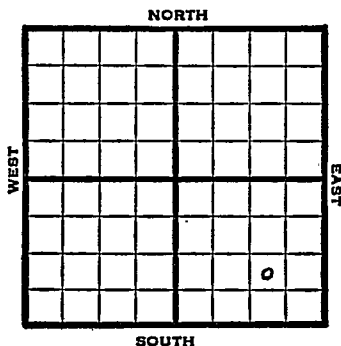

NW SE SE

1947 Elev. 1818' REPORT

7/9 Location

7/16 8" @ 593'
Drlg. 2100'

7/22 Drlg. 3435

7/30 Arb. 3512'
TD 3533'

ABANDONED

Map No. _____ Sec. 12 Twp. 21 R. 12W

Well No. 2 Schrepel

Sohio Company

FIRST REPORT

Contractor

NW SE SE

SECTION PLAT

_____ Ft. from N. Line

990 Ft. from S. Line

990 Ft. from E. Line

_____ Ft. from W. Line

			o

Stafford County

Location X

Rig up

Drilling and Remarks:

RECORD

Cased _____ in., _____ ft.

Sand _____

Gas _____

Oil _____

Total Depth _____

PRODUCTION

1st 24 hrs. Nat. _____

1st 24 hrs. after shot _____

Gas _____ Cu. Ft.

Dry Hole _____

Abandoned _____

Date

JUL 9 1947 19

S. J. LEWIS Scout

