

KANSAS

Section 12 Township 21 Range 16W

Well No. 2 Smith

Company Bay Petr.

Ash Creek

NORTH

						○	

WEST

EAST

SOUTH

12 KANSAS Pawnee 21 R. 16W

Well No. #2 Smith Farm  
Bay Pet. Company

C W L NE NE


660 Ft. from N. Line

Ft. from S. Line

990 Ft. from E. Line

Ft. from W. Line

C W L NE NE

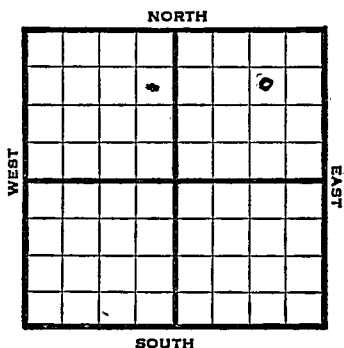

1947 Elev. 1967' REPORT

10/22 RUR  
10/29 8" @ 955'  
Drlg. 2100'  
11/5 Drlg. 3705'  
11/12 Lansing 3416'  
Arbuckle 3757'  
5" @ 3744'  
TD 3780'  
RUST  
11/19 TD 3783'  
500 Acid  
Flow 7 bbls oil PH  
11/25 "  
12/3 Arbuckle 3757'  
5" @ 3744'  
Acid 1500  
Flow 199 Pot  
Gr. 39°  
Total Depth 3783'

**COMPLETED**

Map No. \_\_\_\_\_ Sec. 12 Twp. 21 R. 16W

Well No. 2 Smith

Bay Pet. \_\_\_\_\_ Company

**FIRST REPORT** \_\_\_\_\_ Contractor

C W L NE NE

**SECTION PLAT**

660 Ft. from N. Line

\_\_\_\_\_ Ft. from S. Line

990 Ft. from E. Line

\_\_\_\_\_ Ft. from W. Line

			o

Paynee County

Location \_\_\_\_\_

Rig up \_\_\_\_\_

Drilling and Remarks:

**BUR**

**RECORD**

Cased \_\_\_\_\_ in., \_\_\_\_\_ ft.

Sand \_\_\_\_\_

Gas \_\_\_\_\_

Oil \_\_\_\_\_

Total Depth \_\_\_\_\_

**PRODUCTION**

1st 24 hrs. Nat. \_\_\_\_\_

1st 24 hrs. after shot \_\_\_\_\_

Gas \_\_\_\_\_ Cu. Ft.

Dry Hole \_\_\_\_\_

Abandoned \_\_\_\_\_

Date

OCT 22 1947 19 \_\_\_\_\_

S. J. LEWIS Scout

