


NE SW SE

PETROLEUM, INC.

GATES "C" #3

Township 21s Range 13W County STAFFORD State KANSAS

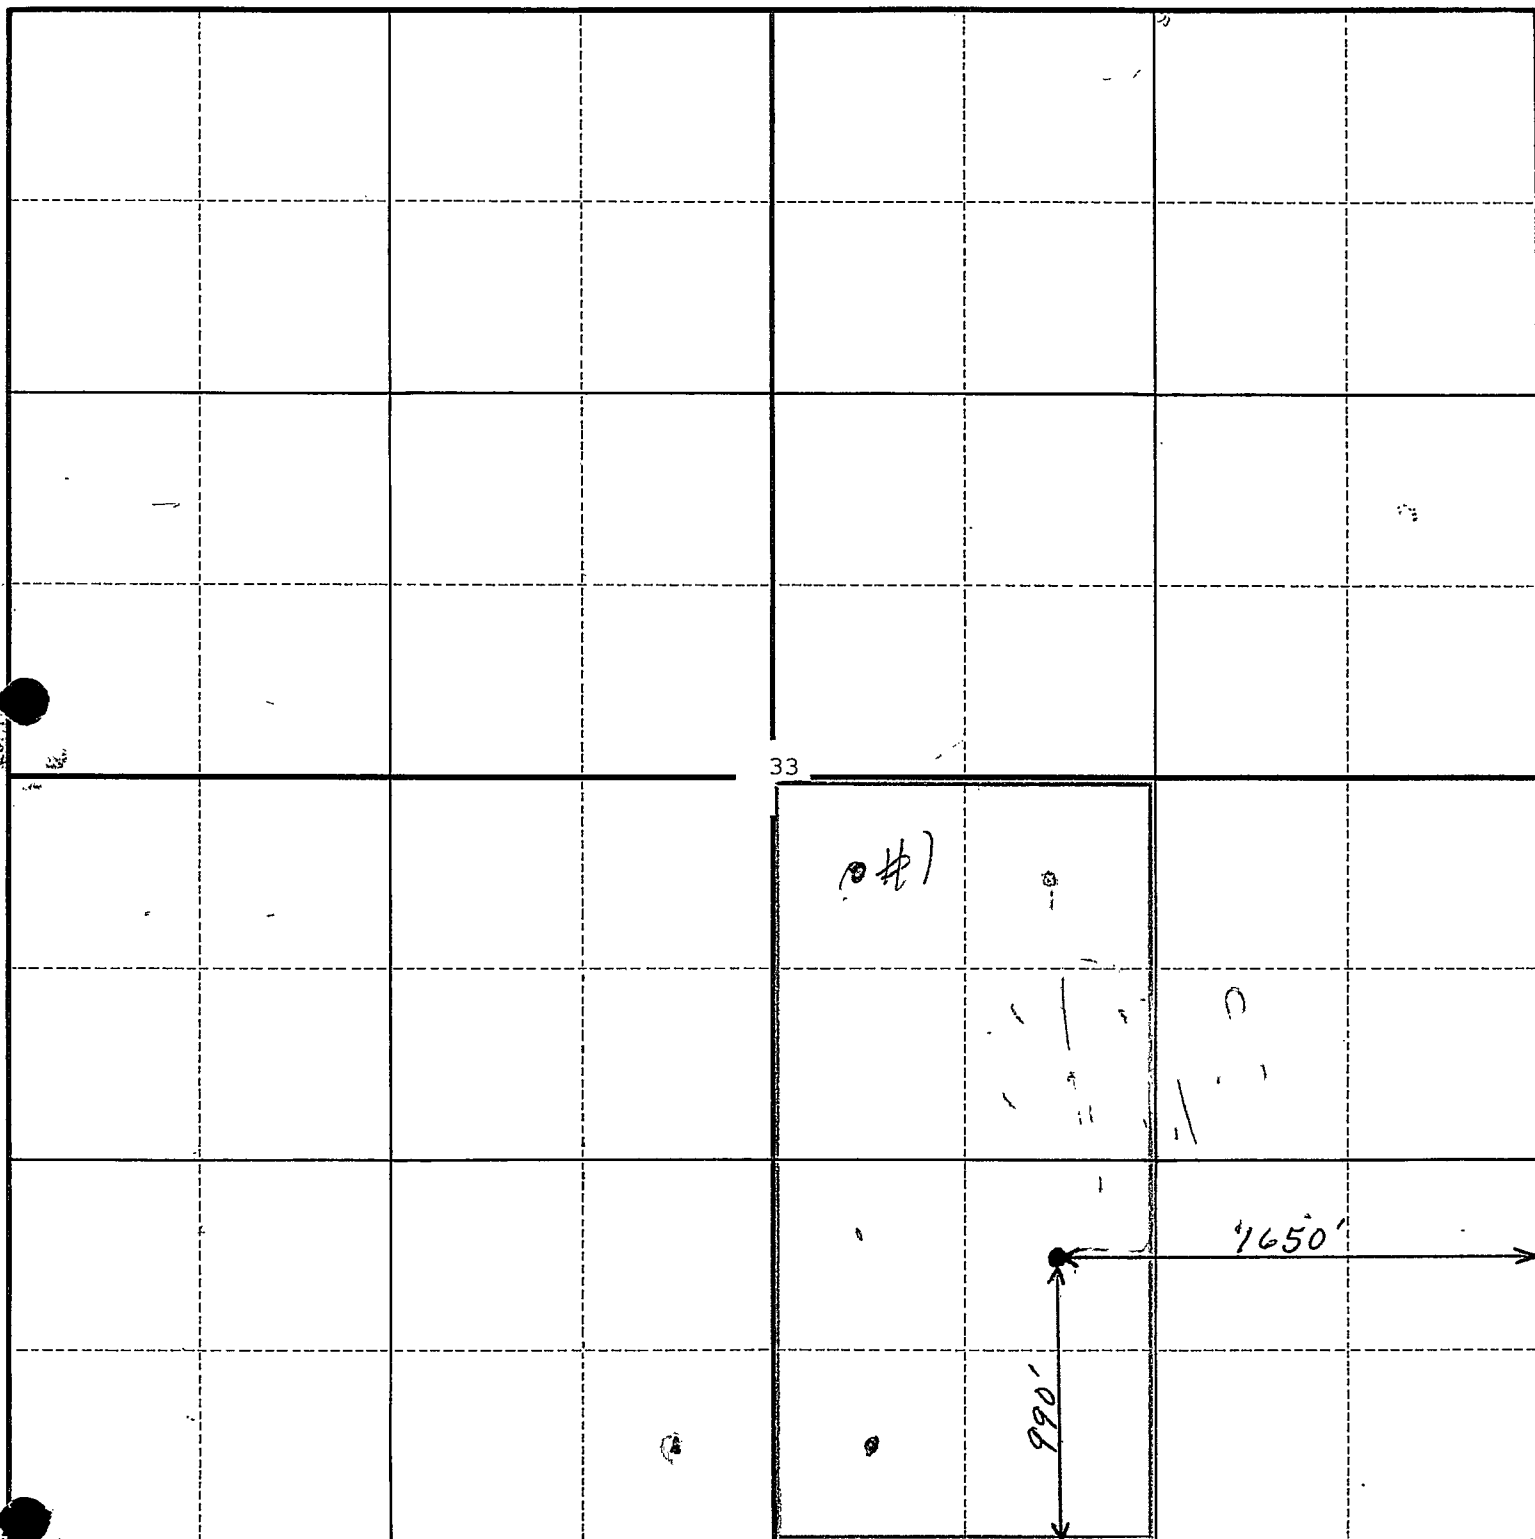

990' N. OF S.L.
1650' W. OF E.L.

LOCATION: $\frac{1}{2}$ MILE NORTH OF SEWARD CORNER
ON HIWAY 281, WEST INTO LOCATION.

FORM. 45-8

LSW-10-17-62

RIG #8