


Section 13 Township 21 Range 13WWell No. #3 BatmanCompany Westgate-Greenland

NORTH

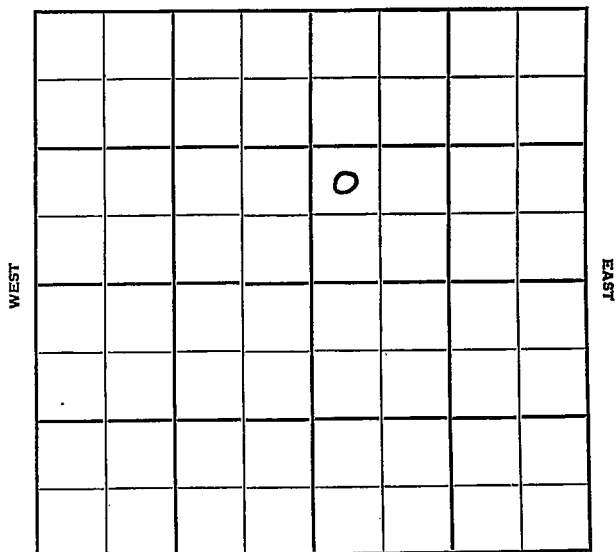

SOUTH

Stafford


KANSAS ✓

Sec. 13 Twp. 21 R. 13W

Well No. #3 Batman Farm _____
Westgate-Greenland Company _____
Westgate Drlg. Corp. Contractor _____

_____ Ft. from N. Line
990 _____ Ft. from S. Line
 _____ Ft. from E. Line
330 _____ Ft. from W. Line

NW SW NE

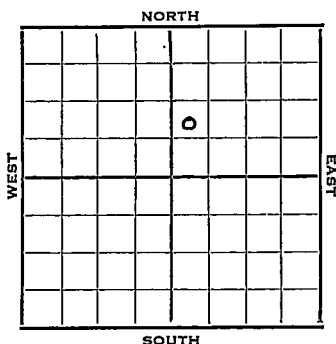

1952 Elev. 1862' REPORT

8/13 Spud 8-8-52
 8" @ 244'
 Anhy 713'
 Drlg. 1765'
 8/20 Heeb. 3139 Br Li 3266
 Lans. 3280
 Drlg. 3331'
 8/27 DST 3295-3327', 1 hr. 15' m
 B KC 3494 Cherty Cong 3518
 Arb. 3565
 DST 3566-75, 1 hr. 1080' gas, 45'
 HO&GCM, 120' frothy oil, 60' oil
 750#
 DST 3578-87, 1 hr. 60' HO&GCM
 200' frothy oil 200' free oil
 1050# TD 3607' 5" @ 3602'
 9/3 CO 3600 68/3565-86 fill up
 600' oil 3 hrs S/8 BOPH
 9/10 Spud 8-8-52
 Oil Well TD 3607 8" @ 244'
 Anhy 713 Heeb. 3139
 Br Li 3266 Lans. 3280
 DST 3295-3327 open 1 hr. rec. 15' mud
 O# B KC 3494 Ch Cong. 3518
 Arb. 3565
 DST 3566-75 open 1 hr. rec. 1680' gas
 45' ho&gcm 120' frothy oil 60' oil
 750#

OVER

1952

9/10 DST 3578-87 open 1 hr. rec. 60'
ho&gcm 200' frothy oil 200' free oil
1050# TD 3607 7" @ 3602' DP to 3600
68/ 3565-86 FU 600' oil 3 hr.
S/ 8 boph Comp. 241 bopd

COMPLETED

County Stafford State KansasSec. 13 (Blk.) 21 (Sur.) 13W Map No.Operator Westgate-GreenlandWell No. 3 Farm BatmanElev. Location NW SW NE

FIRST REPORT

990 Ft. From S Line NE330 Ft. From W Line Quarter1st. Report AUG 13 1952

Completion

Remarks

Westgate Drlg. Corp-Contr.Spudding Date 8-8-52

Drlg. Data

8" @ 244 Anhy 713 Drlg. 1765J. G. McGEHEE

Scout Cards	mm
Land Small Map	
Land Wall Map	
Tracings	
France Map	
Pierce Map	
Misc.	

AUG 15 1952

Drig. Data

County	Stafford		State	Kansas	
Sec.	13	(Blk. Twp.)	21	(Sur. Rge.)	13W Map No.
Operator	Westgate-Greenland				
Well No.	3	Farm	Batman		
Elev.	1862	Location	NW SWNE		

990 Ft. From S Line NE

330 Ft. From W Line Quarter

1st. Report

Completion SEP 10 1952

Remarks

Westgate Drlg. - Contr.

Spudding Date 8-8-52

Drilg. Data Oil well TD 3607

8" @ 244 Anhy 713 Heeb. 3139

Br. lime 3266 Lans. 3280 DST 3295-3327

open 1 hr. Rec. 15' mud 0#

B KC 3494 Ch. Cong. 3518 Arb. 3565

DST 3566-75 open 1 hr. Rec. 1680' gas

45' ho & gcm 120' frothy oil 60' oil

750# DST 3578-87 open 1 hr. Rec.

60' ho & gcm 200' frothy oil 200' free

oil 1050# TD 3607 7" @ 3602

DP to 3600 68/ 3565-86 FU 600' oil

3 hr. S/ 8 boph Comp. 241 bopd

J. G. McGEHEE

Scout Cards *mf*
 Land Snail Map
 Land Wall Map *3P*
 Tracings
 France Map
 Pierce Map
 Misc.

SEP 17 1952

Orig. Data