


Section 13 Township 21N Range 13W

Well No. #1 Batman

Company Westgate-Greenland

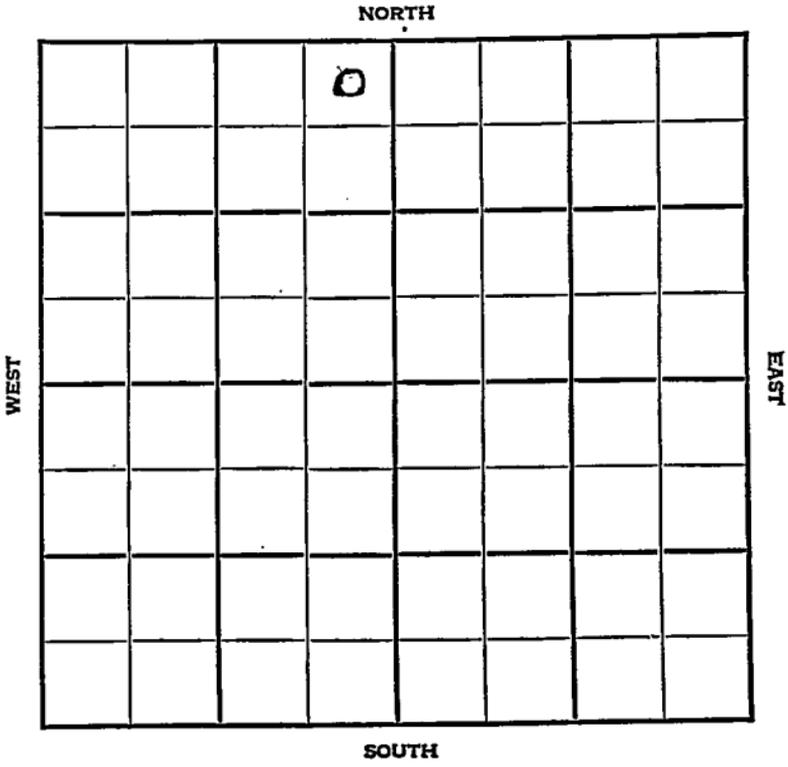

Sec. 13 Twp. 21 R. 13W

Well No. #1 Batman Farm

Westgate-Greenland Company
Wildcat


330' Ft. from N. Line

_____ Ft. from S. Line

330' Ft. from E. Line

_____ Ft. from W. Line

NE NW

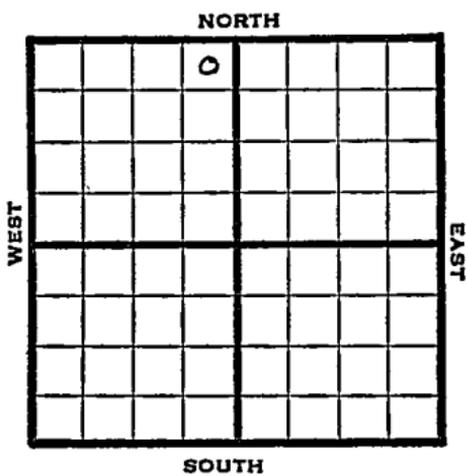

1948

Elev. 1862 REPORT

6/9

10" @ 286'
Drlg. 2325'

6/16

TD 3615'
Lansing-3274'
Arb. 3564'
Aband.

ABANDONED

Map No. _____ Sec. 13 Twp. 21 R. 13W

Well No. 1 Batman


Westgate-Greenland Company

FIRST REPORT Contractor

NE NW

SECTION PLAT

330 Ft. from N. Line

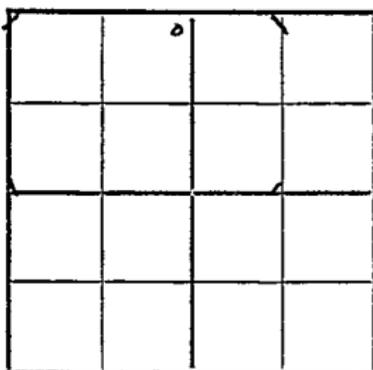

_____ Ft. from S. Line

330 Ft. from E. Line

_____ Ft. from W. Line

Stafford County

RECORD

Location _____

Cased _____ in., _____ ft.

Rig up _____

Sand _____

Drilling and Remarks:

Gas _____

10" @ 286

Oil _____

drlg. 2325

Total Depth _____

PRODUCTION

1st 24 hrs. Nat. _____

1st 24 hrs. after shot _____

Gas _____ Cu. Ft.

Dry Hole _____

Abandoned _____

Date

JUN 9 1948

S. J. LEWIS

19

Scout

Map No. 82 Sec. 13 Twp. 21 R. 13W

Well No. 1 Batman

Westgate-Greenland Company

ABANDONED

Contractor

NE NW

E. I. 1962
SECTION PLAT

330 Ft. from N. Line

_____ Ft. from S. Line

330 Ft. from E. Line

_____ Ft. from W. Line

	0		

Stafford County

Location _____

Rig up _____

Drilling and Remarks:

Case 3274

Cr 83564

RECORD

Cased _____ in., _____ ft.

Sand _____

Gas _____

Oil _____

Total Depth 3615

PRODUCTION

1st 24 hrs. Nat. _____

1st 24 hrs. after shot _____

Gas _____ Cu. Ft.

Dry Hole _____

Abandoned _____

Date

JUN 16 1948

19

S. J. LEWIS

Scout