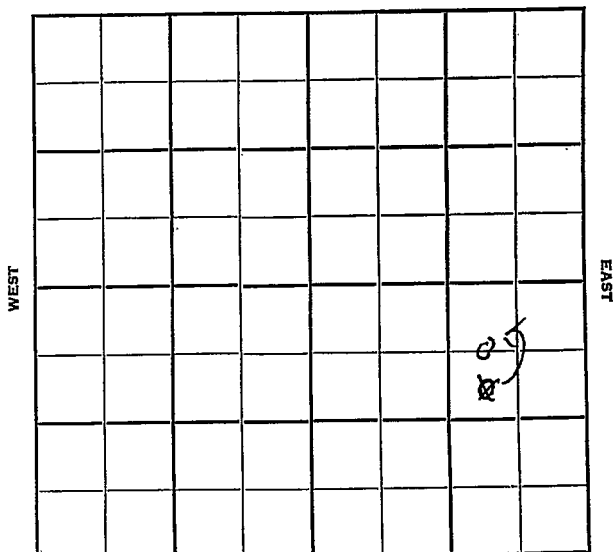


Section 13 Township 21 Range 13 WWell No. # 3 BatmanCompany M. B. Armer

NORTH



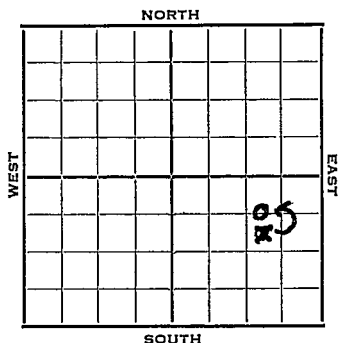
SOUTH

Sec. 13 Twp. 21 R. 13WWell No. #3 Batman FarmM. B. Armer CompanyM. B. Armer Contractor660
990 Ft. from N. Line

Ft. from S. Line

990 Ft. from E. Line

Ft. from W. Line

C W L N E S E
~~SW NE SE~~

1952

Elev. 1862' REPORT

6/25 Spud 6-21-52
8" @ 275'
Drlg. 780'

7/2 Anhy 1680' Heeb 3118' Br Li 3244'
Lans. 3262' Cong. 3492'
Drlg. 3522'

7/9 Arb. 3540'
DST 3542-45, 1 hr, 640' oil, 1028#
TD 3545' 5" @ 3542' RUST

7/17 NR

7/23 CO DD 3546 TD S/ 13 Boph
nat. POP

7/30- NR

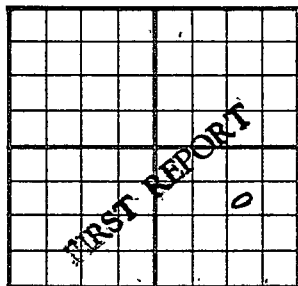
8/6 "

8/13 "

8/20 "

8/27 Spud 6-21-52
Oil Well TD 3546'
8" @ 275'
Anhy 1680 Heeb. 3118
Br Li 3244 Lans. 3262
Cong. 3492 Arb. 3540
DST 3542-45 open 1 hr. rec. 640'
oil 1028# TD 3545 5" @ 3542
DD 3546' S/ 13 boph
Comp. 243 bopd

COMPLETED

County Stafford State KansasSec. 13 (Blk. 21 (Sur. 13N Map No.)
(Twp.) (Rge.)Operator M. B. ArmerWell No. 3 Farm BatmanElev. Location SW NE SE990 Ft. From N Line SE990 Ft. From E Line Quarter1st. Report JUN 25 1952Completion Remarks M. B. Armer - Contr.Spudding Date 6-21-52Drlg. Data 8" @ 275 Drlg. 780

J. G. McGEHEE

Kansas

Map No. _____ Sec. 13 Twp. 21 R. 13W

Well No. 3 Batman

M. B. Armer _____ Company

CORRECTION _____ Contractor

C W L N E S E

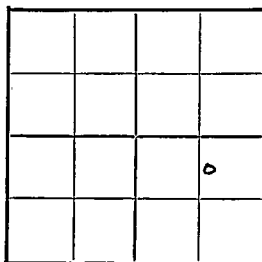
SECTION PLAT

660 _____ Ft. from N. Line

_____ Ft. from S. Line

990 _____ Ft. from E. Line

_____ Ft. from W. Line



Stafford County

Location _____

Rig up _____

Drilling and Remarks:

Reported

SW NE SE

RECORD

Cased _____ in., _____ ft.

Sand _____

Gas _____

Oil _____

Total Depth _____

PRODUCTION

1st 24 hrs. Nat. _____

1st 24 hrs. after shot _____

Gas _____ Cu. Ft.

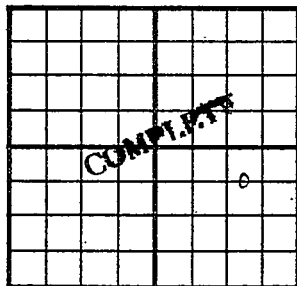
Dry Hole _____

Abandoned _____

Date

JUL 2 1952 19

J. G. McGEHEE Scout

County Stafford State KansasSec. 13 (Blk.) 21 (Sur.) 13W Map No.Operator M. B. ArmerWell No. 3 Farm BatmanElev. 1862 Location C W L NE SE660 Ft. From N Line SE990 Ft. From E Line Quarter

1st. Report

Completion AUG 27 1955

Remarks

Armer - Contr.Spudding Date 6-21-52Drlg. Data Oil well TD 35468" @ 275 Anhy 1680 Heeb. 3118Br. lime 3244 Lans. 3262 Cong. 3492Arb. 3540 DST 3542-45 open 1 hr.Rec. 640' oil 1028# TD 3545 5" @ 3542DD 3546 S/ 13 boph Comp. 243 bopd