

Stafford

Sec. 13 Twp. 21 R. 13W

Well No. 6 Batman "B" Farm

Herman Kiser Company

Armer - Contr. Contractor

Ft. from N. Line

330


Ft. from S. Line

Ft. from E. Line

990

Ft. from W. Line

SE SW SE

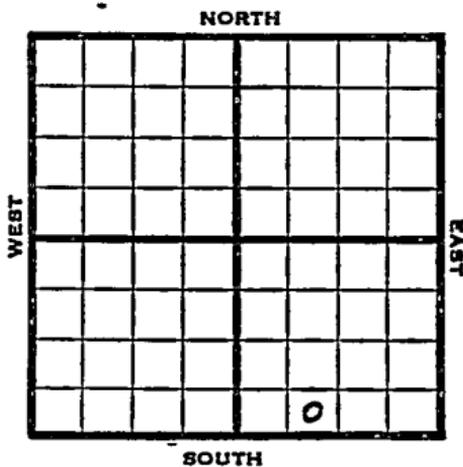

1953

Elev. 1866' REPORT

- 4/1 Spud 3-28-53
8" @ 294
Drlg 2590
- 4/9 Heeb 3140' Br li 3266 Lans 3285'
DST 3309-28, 1 hr, 65' OCM, 840'
oil 1190#
DST 3337-57', 1 hr, 180' HO & GCM
420' O & W 80% wtr., 2030' wtr.
1130#
Drlg. 3370'
- 4/16 DST 3456-75 1 Hr. 20' ocm 0# Cong
3514
DST 3518-97 1 hr. 30' M Arb 3609
DST 3624-28 1 hr. 35' M
DST 3644-52 D. Packer 1 Hr. 20' M
RTD 3670
5" @ 3400'
- 4/23 CO 3372 12/3343-46 HFW
Plug 3340' 16/3324-28 FU 300' oil
1 hr. S/5 1/2 BOPH 5% wtr. G. 16
- 4/30 NR
- 5/7^M "
- 5/21 NR
- 5/28 "
- 6/3 NR

OVER

1953
6/10

Spud 3-28-53 Oil well TD 3670
8" @ 294 Heeb 3140 Br lime 3266
Lans 3285
DST 3309-28 open 1 hr. rec 65' OCM
840' oil 1190#
DST 3337-57 open 1 hr rec 180' HO
& GCM, 420' O & wtr. 80% wtr.
2030' wtr. 1130#
DST 3456-75 open 1 hr rec 20' OCM O#
Cong. 3514
DST 3518-97 open 1 hr rec 30' mud
Arb. 3609
DST 3624-28 open 1 hr rec 35' mud
DST 3644-52 open 1 hr rec 20' mud
TD 3670 5" @ 3400 GO to 3372
12/3343-46 HFW SP 3340 16/3324-28
FU 300' oil 1 hr. S/5 $\frac{1}{2}$ BOPH 5% wtr.
Comp. 140 BOPD 2% wtr.

COMPLETED

APR 6 1953

Scout Cards	_____	RP
Land Small Map	_____	
Land Wall Map	_____	CP
Tracings	_____	
France Map	_____	
Pierce Map	_____	
MISC.	_____	

Orig. Data

JUN 16 1953

Scout Cards	<i>mm</i>
Land Study Map	
Land Wall Map	<i>B</i>
Tracings	
France Map	
Pierce Map	
Misc.	

Dirg. Data