


Section 13 Township 21 Range 14 WWell No. # 1 WrightCompany M. B. Armer

NORTH

WEST

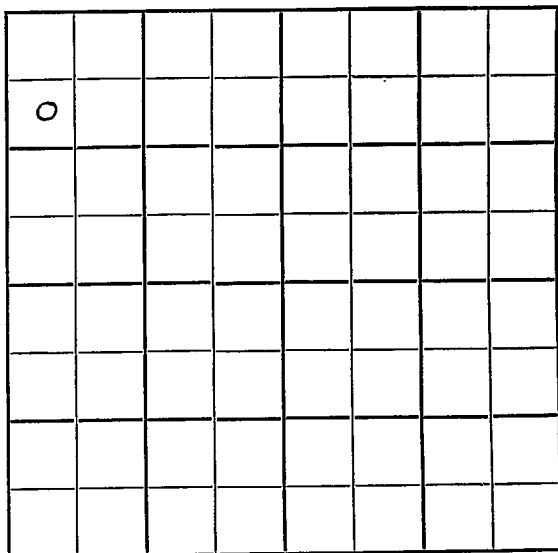

EAST

SOUTH

Stafford

KANSAS

Sec. 13 Twp. 21 R. 14 W ✓

Well No. # 1 Wright Farm

M. B. Armer Company

Contractor

990 Ft. from N. Line


 Ft. from S. Line

 Ft. from E. Line

330 Ft. from W. Line

SW NW NW

Phillips Farmout

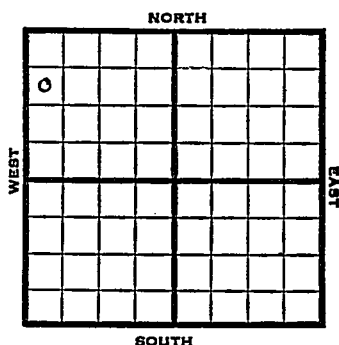


1951 Elev. 1926' REPORT

4/11 Spud 4-10-51
8" @ 266'

5/9 Spud 4-10-51
D&A " TD 3690
8" @ 266
Anhy 825' Heeb. 3234
Tor. 3256 Br Lime 3353
Lans. 3365 Cong. 3611
Viola 3618 Simp 3641
Arb. 3687-89 5" @ 3687
TD 3690
S/2 $\frac{1}{2}$ boph wtr inc. S/2 $\frac{1}{2}$ bfph
80% wtr SP 3679
Perf 3488-98 500 A S/52 bw
6 bopd
D&A **ABANDONED**

County Stafford State Kansas
 Sec. 13 (Blk. Twp.) 21 (Sur. Rge.) 14W Map No.
 Operator M. B. Armer
 Well No. 1 Farm Wright
 Elev. _____ Location SW NW NW

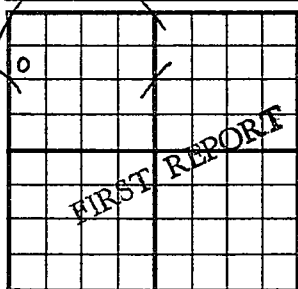


990 Ft. From N Line NW
330 Ft. From W Line Quarter
 1st. Report APR 11 1951
 Completion _____
 Remarks Phillips farmout
 Spudding Date 4-10-51

Drlg. Data

8" @ 266

J. E. TYRA

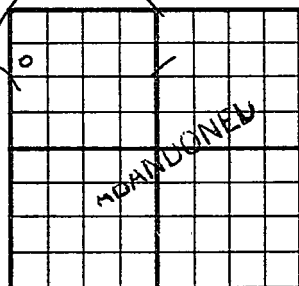County Stafford State KansasSec. 13 (Blk.) 21 (Sur.) 14W Map No.Operator M. B. ArmerWell No. 1 Farm WrightElev. 1926 Location SW NW NW990 Ft. From N Line NW330 Ft. From W Line Quarter1st. ReportCompletion MAY 9 1951RemarksSpudding Date 4-10-51Drlg. Data D & A TD 36908" @ 266 Anhy 825 Heeb. 3234Tor. 3256 Br. lime 3353 Lans. 3365Cong. 3611 Viola 3618 Simp. 3641Arb. 3687-89 5" @ 3687 TD 3690S/ $2\frac{1}{4}$ boph water inc. S/ $2\frac{1}{2}$ bfph80% water SP 3679 Perf. 3488-98 500 AS/ 52 bw 6 bopdD & A

J. E. TYRA