

Section 13 Township 21 Range 14WWell No. #2 McGintyCompany Petroleum, Inc.

NORTH

						0	

WEST

EAST

SOUTH

Stafford

KANSAS

Sec. 13 Twp. 21 R. 14 W

Well No. # 2 McGinty Farm

Petroleum Inc. Company

Garvey Contractor
McGinty


 Ft. from N. Line

990 Ft. from S. Line

990 Ft. from E. Line

 Ft. from W. Line

NW SE SE

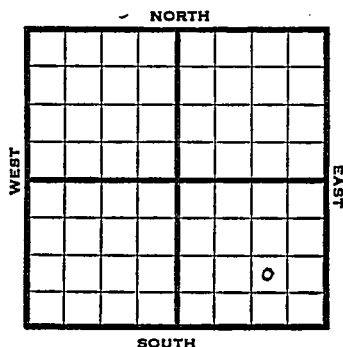

1951

Elev. 1924' REPORT

11/7

Spud 11-2-51
8" @ 230'
Drlg. 2915'

11/14

Spud 11-2-51
D&A TD 3691
8" @ 230
Heeb. 3222 Tor. 3242
Br. Lime 3341 Ians. 3353
DST 3475-3501 open $\frac{1}{2}$ hr.
Rec. 5' mud
DST 3504-26 open 45 min.
Rec. 12' mud
DST 3531-74 open 45 min.
Rec. 8' mud
Viola 3598 Simp. 3632
DST 3601-34 open 45 min.
Rec. 7' mud
Arb. 3686
DST 3687-91 open $\frac{1}{2}$ hr.
Rec. 93' sul. wtr.
TD 3691'
D&A

ABANDONED

County **Stafford** State **Kansas**

Sec. **13** (Blk.) **21** (Sur.) **147** Map No.

Operator Petroleum Inc.

Well No. **2** Farm **Mc Ginty**

Elev.	Location	NW SE SE

FIRST REPORT

990 Ft. From S Line SE

990 Ft. From E Line Quarter

Ist. Report **NOV 7 1951**

Completion

Remarks

Garvey - Contr.


Spudding Date **11-2-51**

Drlg. Data Mc Ginty

8" @ 230 Drlg. 2915

J. E. TYRA

County Stafford State Kansas
 Sec. 13 (Blk. 21 (Sur. 14W Map No.
 Operator Petroleum Inc.
 Well No. 2 Farm McGinty
 Elev. 1924 Location NW SE SE

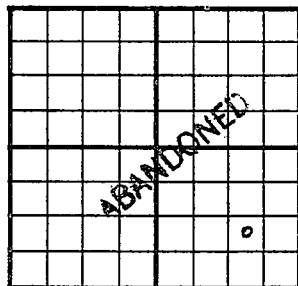

990 Ft. From S Line SE
990 Ft. From E Line Quarter
 Ist. Report
 Completion NOV 14 1951
 Remarks McGinty Pool
Garvey - Contr.
 Spudding Date 11-2-51

Drlg. Data D & A TD 3691
8" @ 230 Heeb. 3222 Tor. 3242
Br. lime 3341 Lans. 3353 DST 3475-3501
open $\frac{1}{2}$ hr. Rec. 5' mud DST 3504-26
open 45 min. Rec. 12' mud DST 3531-74
open 45 min. Rec. 8' mud Viola 3598
Simp. 3632 DST 3601-34 open 45 min.
Rec. 7' mud Arb. 3686 DST 3687-91
open $\frac{1}{2}$ hr. Rec. 93' sul. water TD 3691
D & A