

Stafford KANSAS ✓

SEC.	TWP.	R.
13	21	14 W
WELL NO.		
# 3 McGinty		FARM
COMPANY		

CONTRACTOR John Darrah et al

Garvey


Wildcat
Ft. from N. Line

990 Ft. from S. Line

Ft. from E. Line

330 Ft. from W. Line

NW SW SE

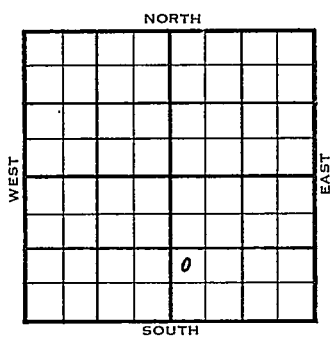

1954	ELEVATION 1923	REPORT
------	----------------	--------

7/14	Spud 7-12-54 8" @ 230 WOC	
7/21	Heeb 3221', Tor 3240', Doug 3259', Br li 3340', Lans 3352' D rlg.	
7/28	Spdg 7-12-54 D&A TD 3740 8" @ 230 Heeb. 3221 Tor. 3240 Doug. 3259 Br.lime 3340 Lans. 3352 DST 3496-3580 open 1 hr. Rec. 65' wtr. 680# Viola 3597 Simp. 3632 Arb. 3690 TD 3740 D&A	

ABANDONED

