

Stafford


KANSAS

SECTION 13 TOWNSHIP 2S RANGE 14W

WELL NO. #1 Wright

COMPANY Hilton Drlg.

NORTH NE NE NW

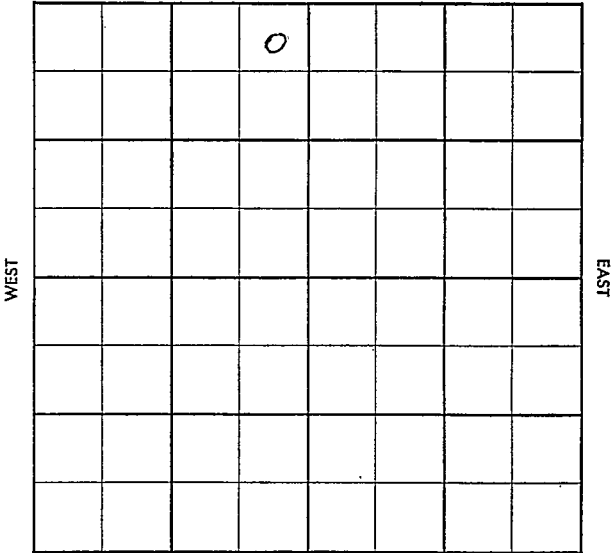

SOUTH

~~Stafford~~ ~~Stafford~~
~~Stafford~~ ~~Stafford~~

S-513-B

County Stafford Elev. _____

Sec. 13 Twp. 21 Rge. 1 W

Company Hilton Drlg.

Farm Name Wright No. 1

TOPS	DEPTH	LOG	DATUM
Anh.			
Tp.			
H.			
Tr.			
Dg.			
B.L.			
L.			
K.C.			
B.K.C.			
Ce.			
C.			
M.			
M.			
K.			
Mz.			
Mq.			
V.			
S.			
S.			
A.			
R.			
Pf.			
G.			
T.D.			

Loc. in Sec. _____

NE NE NW


Geol. _____

Contr. _____

Co. tools

Pool _____

McGinty

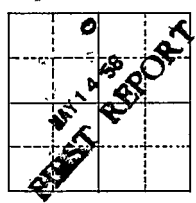

Date Comm. _____

Location

Co. Use. No. Sec. T. R.

Twp. ~~X~~ Pool ~~X~~
 Co. ~~X~~ Facet ~~X~~

S-513-B

County Stafford Elev. 19200F 1923RB
 Sec. 13 Twp. 21 Rge. 1 LW
 Company Hilton Drlg.
 Farm Name Wright No. 1

TOPS	DEPTH	LOG	DATUM
Anh.	<u>815-40</u>		
Tp.			
H.	<u>3232</u>		
Tr.	<u>3247</u>		
Dg.	<u>3277</u>		
B.L.	<u>3349</u>		
L.	<u>3360</u>		
K.C.			
B.K.C.	<u>3574</u>		
Ce.			
C.	<u>3587</u>		
M.			
M.			
K.			
Mz.			
Mq.			
V.	<u>3601</u>		
S.	<u>3637</u>		
S.			
A.	<u>3688</u>		
R.			
Pf.			
G.			
T.D.	<u>3740</u>		

Loc. in Sec. NE NE NW
 Geol. _____
 Contr. _____
 Co. tools _____
 Pool McGinty

0
 JUN 18 58
ABANDONED

Date Comm. 5-28-58 8" 239
 Location MAY 21 '58 MAY 28 '58 JUN 3 '58 JUN 11 '58
Ø 2760 JUN 18 '58 DST 3499-3528 20"
8' M Rambow FPO BHP 150/20" DST
3587-3615 20" 8' M FPO
BHP 20/20" no log

D6A