

Kansas

Map No. _____ Sec. 13 Twp. 21 R. 8W


Well No. 1 - Smyser Farm
Mid-Kansas-Land Company

_____ Ft. from N. Line

990 Ft. from S. Line

_____ Ft. from E. Line

990 Ft. from W. Line

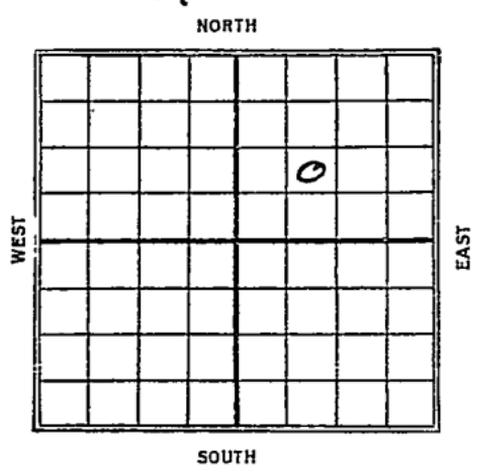

1927

Date	REPORT
2/16	Rig
4/23	Spud
3/2	Spud 200
3/9	Drlg 700
3/16	" 1500
3/23	" 1820
3/30	" 2070
4/6	" 2475
4/13	" 2620
4/20	" 2740
4/27	" 3015
5/4	" 3240
5/11	top chat 3348 - Base 3380
	show oil - Drlg 3490 -
5/25	T.D. 3490 - U.R. 6"
6/1	T.D. 3635 - S.D.
6/8	Top Wilcox 3720 - Drlg 3725
6/15	T.D. 3730 - S.D.
6/22	Drlg 3945
6/29	T.D. 4029 D + a

Map No. *Rice* **KANSAS** Sec. *13* Twp. *21* R. *8W*

Well No. *1 Snyder*

Mid-Kansas & Sandon Company

Contractor

SECTION PLAT

----- Ft. from N. Line

990 Ft. from S. Line

----- Ft. from E. Line

990 Ft. from W. Line

		o	

FIRST REPORTS

Location -----

Rig up -----

Drilling and Remarks:

Rig

RECORD

Cased ----- in., ----- ft.

Sand -----

Gas -----

Oil -----

Total Depth -----

PRODUCTION

1st 24 hrs. Nat. -----

1st 24 hrs. after shot -----

Gas ----- Cu. Ft.

Dry Hole -----

Abandoned -----

Date

FEB 16 1927

S. J. LEWIS

Scout

MAP No. _____ SEC. 13 TWP. 71S R. 8W

WELL No. 1 Survey

Mid-Kansas COMPANY

[Signature] CONTRACTOR

SECTION PLAT

		⊙	

no well

_____ FT. FROM N. LINE

_____ FT. FROM S. LINE

_____ FT. FROM E. LINE

_____ FT. FROM W. LINE

RECORD

LOCATION _____

CASED _____ IN. _____ FT.

RIG UP _____

SAND _____

DRILLING AND REMARKS:

GAS _____

lime

OIL _____

TOTAL DEPTH 1079

PRODUCTION

1ST 24 HRS. NAT. _____

1ST 24 HRS. AFTER SHOT _____

GAS _____ CU. FT.

DRY HOLE ✓

ABANDONED _____

DATE

6/28 1927

SCOUT

Map No. KANSAS Sec. 13 Twp. 21 R. SW

Well No. 1 Sangs

Mid-Kansas & Sanction Company

Contractor

SECTION PLAT

----- Ft. from N. Line

990 Ft. from S. Line

----- Ft. from E. Line

990 Ft. from W. Line

		0	

ABANDONED

Location -----

Rig up -----

Drilling and Remarks:

TJ 4029

J + A

RECORD

Cased ----- in., ----- ft.

Sand -----

Gas -----

Oil -----

Total Depth -----

PRODUCTION

1st 24 hrs. Nat. -----

1st 24 hrs. after shot -----

Gas ----- Cu. Ft.

Dry Hole -----

Abandoned -----

Date -----

JUN 29 1927

S. J. LEWIS

Scout