


Section 13 Township 21 Range 12 W

Well No. # 1 Eveleigh

Company Isern Drlg.

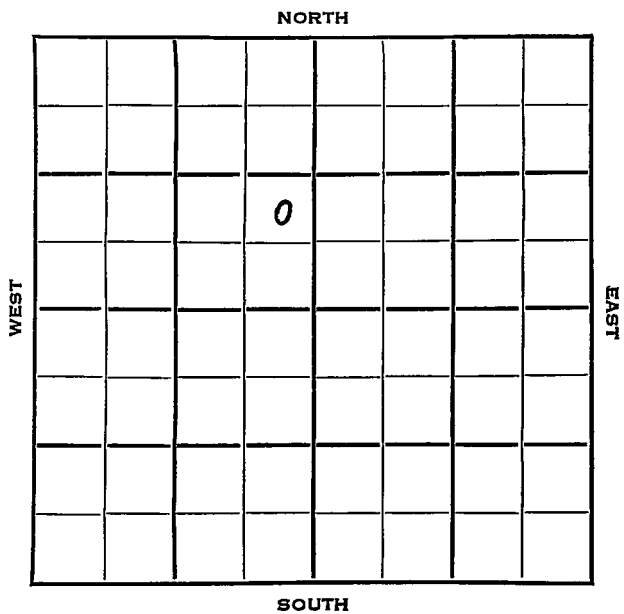

Stafford

KANSAS

SEC.	TWP.	R.
13	21	12 W

WELL NO.

1 Eveleigh


FARM

COMPANY

Isern Drlg.

CONTRACTOR

_____ Ft. from N. Line
 990 _____ Ft. from S. Line
 330 _____ Ft. from E. Line
 _____ Ft. from W. Line

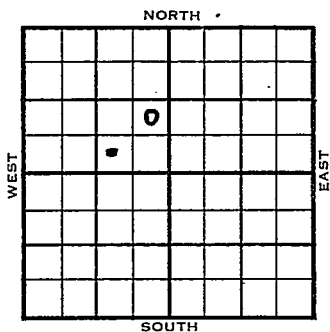

NE SE NW

Phillips DHM & Acrage

	ELEVATION	REPORT
1953	1823'	

10/28

MIM

11/4

8" @ 242' w/215 sks
 Drlg. 2490'

11/11

Spud 10-30-53 D & A TD 3538
 8" @ 242 Heeb 3044 Br. lime 3169
 Lans. 3188
 DST 3222-57 open 1 hr rec 20' mud
 280#
 DST 3260-85 open 1 hr rec 115' muddy
 wtr. 1100# Viola 3430 Simp. sh.
 3437 Simp. sd 3470 Arb. 3489
 DST 3492-3501 open 45 min rec 10' mud
 0#
 DST 3503-17 open 45 min, rec 10' mud
 0# TD 3540
 Schl tops: Heeb 3043 Tor. 3062
 Br lime 3169 Lans 3188 B KC 3423
 Viola 3428 Simp. 3447 Arb. 3489
 TD 3538' D & A

ABANDONED


County Stafford State Kansas

Sec. 13 (Blk. Twp.) 21 (Sur. Rge.) 12W Map No.

Operator Isern Drlg.

Well No. 1 Farm Eveleigh

Elev. _____ Location NE SE NW

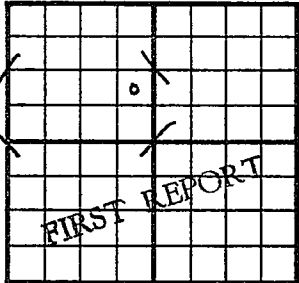

990 Ft. From S Line NW

330 Ft. From E Line Quarter

1st. Report OCT 28 1953


Completion _____

Remarks Phillips DEM & AC

Spudding Date _____

Drig. Data _____

H I M

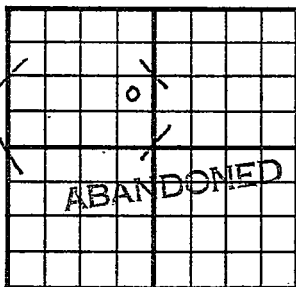County Stafford State KansasSec. 13 (Blk. Twp.) 21 (Sur. Rge.) 12W Map No.Operator Isern Drlg.Well No. 1 Farm EveleighElev. 1823 Location NE SE NW990 Ft. From S Line NW330 Ft. From E Line Quarter

1st. Report _____

Completion NOV 11 1953

Remarks _____

Spudding Date 10-30-53Drlg. Data D & A TD 35388" @ 242 Heeb. 3044 Br. lime 3169Lans. 3188 DST 3222-57 open 1 hr.Rec. 20' mud 280# DST 3260-85open 1 hr. Rec. 115' muddy wtr. 1100#Viola 3430 Simp. sh. 3437 Simp. sd. 3470Arb. 3489 DST 3492-3501 open 45 min.Rec. 10' mud 0# DST 3503-17 open45 min. Rec. 10' mud 0# TD 3540SCHLUMBERGER TOPS:Heeb. 3043 Tor. 3062 Br. lime 3169Lans. 3188 B KC 3423 Viola 3428Simp. 3447 Arb. 3489 TD 3538D & A

J. G. McGEHEE