


Section 13 - Township 21 Range 12-W

Well No. 2 Eveleigh

Company Phillips

Sandigo Pool

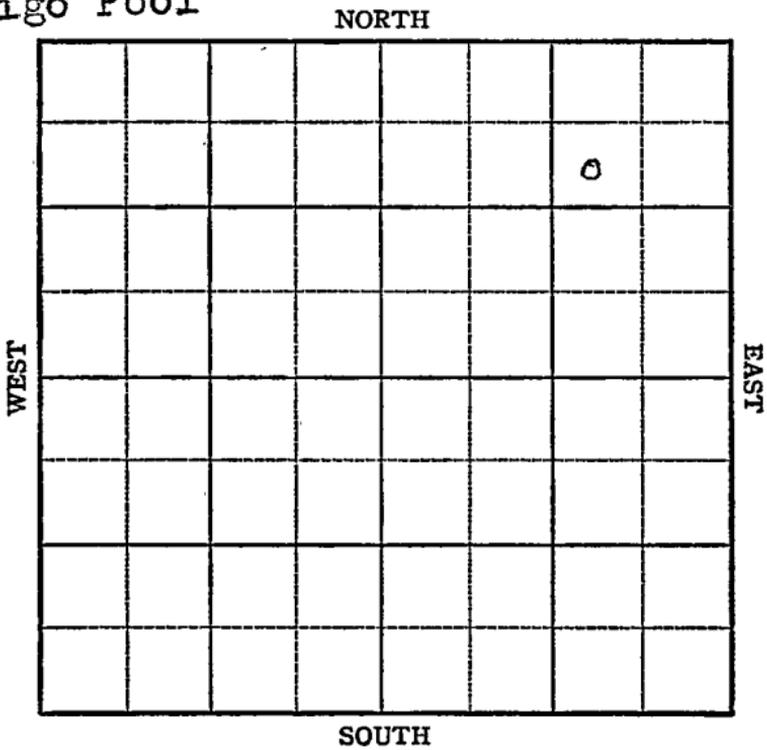

KANSAS

Stafford ✓

Sec. 13 Twp. 21 R. 12W

Well No. #2 Eveleigh Farm


Phillips Company

990 Ft. from N. Line

 Ft. from S. Line

990 Ft. from E. Line

 Ft. from W. Line

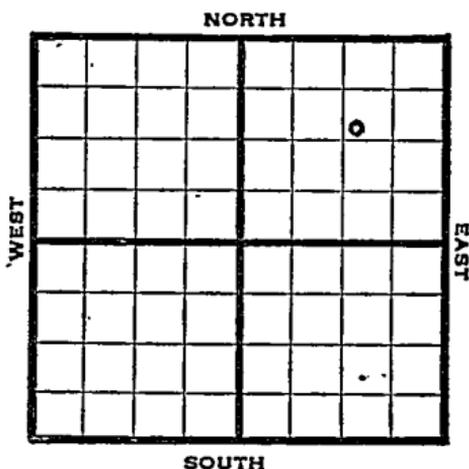

SW NE NE

Elev 1816 645

1947

REPORT

- 10/8 Location
- 10/15 8" @ 600'
Drlg. 1635'
- 10/22 Lansing 3180'
Drlg. 3330'
- 10/29 Viola 3417'
Simpson 3443'
Arbuckle 3489'
TD 3495'
5" @ 3495'
RUST
- 11/5 TD 3515'
1675' Water & 425 oil
swb 7 bbls oil & 81 W in 10 hrs.
- 11/12 Plug 3800'
60 shots 3270-85'
20 shots 3258-63'
20 shots 3250-55' - 1500 acid W.
- 11/19 "
- 11/25 "
- 12/3 "
- 12/10 "

OVER

1947

12/17. Arbuckle 3489'
TD 3515'

ABANDONED

Map No. _____ Sec. 13 Twp. 21 R. 12W

Well No. 2 Eveleigh

Phillips Company

FIRST REPORT Contractor _____

S7 NE NE

SECTION PLAT

990 Ft. from N. Line

_____ Ft. from S. Line

990 Ft. from E. Line

_____ Ft. from W. Line

			Ø

Stafford County

Location X

Rig up _____

Drilling and Remarks:

RECORD

Cased _____ in., _____ ft.

Sand _____

Gas _____

Oil _____

Total Depth _____

PRODUCTION

1st 24 hrs. Nat. _____

1st 24 hrs. after shot _____

Gas _____ Cu. Ft.

Dry Hole _____

Abandoned _____

Date

OCT 8 1947 19 _____

S. J. LEWIS Scout

Misc. Small Maps _____

Cards *Ruth* _____

Tracing _____

France Map _____

Sec. Leitch Map _____

Flora Map _____

Ceological Dept. _____

Pierce Plat Book _____

Kansas

Map No. 46 Sec. 13 Twp. 21 R. 12WWell No. 2 EveleighPhillips Company

ABANDONED

Contractor

SW NE NE

E. 1876

SECTION PLAT

990 Ft. from N. Line Ft. from S. Line990 Ft. from E. Line Ft. from W. Line

			6

Stafford County

Location Rig up

Drilling and Remarks:

CR 83489

RECORD

Cased in., ft.Sand Gas Oil Total Depth 2515

PRODUCTION

1st 24 hrs. Nat. 1st 24 hrs. after shot Gas Cu. Ft.Dry Hole Abandoned

Date

DEC 17 1947

19

S. J. LEWIS

Scout

T. F. F.

VI

1903



W. J. S.

NAME _____

Elaine

Map _____

Geological Dept. _____

Pierce Plat Book _____