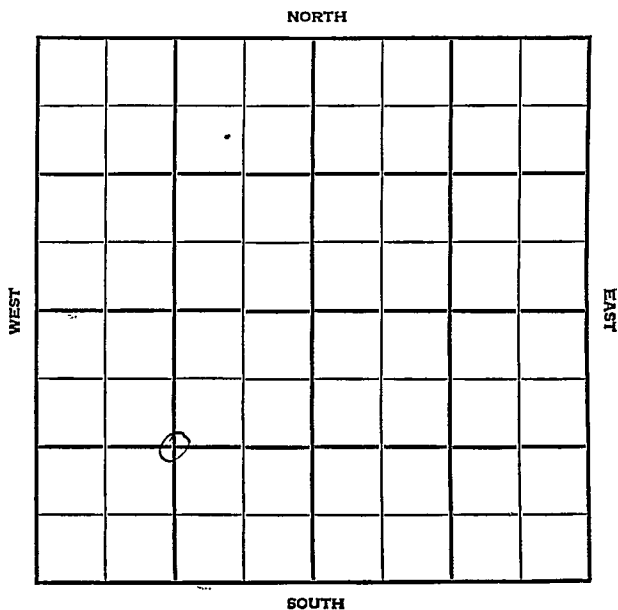


Section 21 Township 21 Range 34 WWell No. #1 FleagleCompany Petroleum Inc.

Finney

KANSAS

SEC.	TWP.	R.
13	21	34W

WELL NO.

#1 Fleagle

FARM

COMPANY

Petroleum Inc.

CONTRACTOR

Garvey


Hugoton

_____ Ft. from N. Line

_____ Ft. from S. Line

_____ Ft. from E. Line

_____ Ft. from W. Line

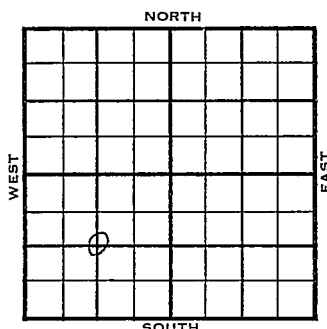

C SW/4

NCRA = FO

1955

ELEVATION

2926'

REPORT

9/7

Comm 9-1-55

H Herr 2521

U Ir 2544

L Kri 2571

Winf 2604

8" @ 257/200

Drlg 2615

9-21 ~~1955~~ DST 2526-80 op 30" (failed)

5 1/2" @ 2614 w/100 sq sh. breaks

68/2546-60 48/2566-78 frac ga 65 mcf

1000 acid 375 mcfg

D & A

T.D. 2615'

ABANDONED

County

~~Finney~~

Elev.

Sec.

13

~~Twp.~~

21

Rge.

34W

Company

Petroleum Inc.

Farm Name

Hleagle

No.

1

TOPS

DEPTH

LOG

DATUM

Loc. in Sec.

C SW/4

Anh.

Tp.

H. *Nerry*

2521

Tr. *H. Kay*

2544

Dg. *in place*

2571

Bl. *Wind*

2604

L.

K.C.

B.K.C.

Ce.

C.

M.

M.

K.

Mz.

Mq.

V.

S.

S.

A.

R.

P.E.

G.

T.D.

Geol.

Contr.

Garvey

Pool

Hugoton

FIRST REPORT

SEP 7 '55

Date Comm.

9-1-55

NCRA - FO

8" @ 257/200 drlg. 2615

Co.

Lse.

No.

Sec.

T.

R.

County Finney Elev. 2926
 Sec. 13 Twp. 21 Rge. 34W
 Company Petroleum Inc.
 Farm Name Fleagle No. 1

TOPS	DEPTH	LOG	DATUM	Loc. in Sec.
Anh.				C SW/4
Tp.				
H. <u>Herr</u>	<u>2521</u>			
Fr. <u>Q. Kri.</u>	<u>2544</u>			
Dg. <u>L. Kri.</u>	<u>2571</u>			
Bt. <u>Winf</u>	<u>2604</u>			
L.				Geol.
K.C.				Contr.
B.K.C.				Garvey
Ce.				
C.				Pool
M.				Hugoton
M.				
K.				ABANDONED
Mz.				
Ma.				
V.				
S.				
S.				
A.				
R.				
Pe.				
G.				
T.D.	<u>2615</u>			

Date Comm. 9/1/55 N C R A - FO SEP 21 1955
8" 257 w/200 DST 2526-80 open 30" (failed)
5 1/2" 2614 w/100 sq sh breaks 68/2546-60
48/2566-78 frac ga 65 mcf 1000 acid
375 mcfg

D & A