

Section 13 Township 21 Range 34 WWell No. #1 O'BrianCompany B & R Drlg. & NCRA

NORTH

							0

WEST

EAST

SOUTH

Finney

KANSAS

Sec. 13 Twp. 21 R. 34W

Well No. #1 O'Brien Farm

B&R Drlg. & NCRA Company

Contractor

Wildcat


Ft. from N. Line

330' Ft. from S. Line

330' Ft. from E. Line

Ft. from W. Line

SE SE SE

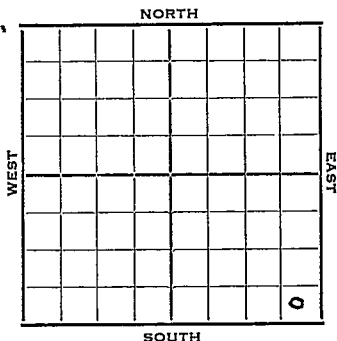

1952 Elev. 2914' REPORT

2/20 Spud 2-15-52
8" @ 272
Drlg. 1220

3/5 DST 4180-4224 1 hr. 2290 SW
1170# DST 4384-4408 2 hr. 20' m
SOC Heeb. 3808 Drlg.

3/12 DST 4461-80 2 hrs. 1270' SW
DST 4514-28 2 hrs. 260' SW
Coring 4681-4731 50' shot & sd
Drlg. 4774'

3/19 Spud 2-15-52
D&A TD 4945
8" @ 272 Hol. 2522 Her. 2553
Kri 2574
DST 2553-2609 opn 1 hr.
Rec. 75' mud 238,000 gas
Win. 2613
DST 4180-4224 opn 1 hr. Rec. 2290' sw
DST 4384-4408 opn 2 hr. Rec. 20' mud
Heeb. 3808 DST 4461-80 opn 2 hr.
Rec. 1270' sw DST 4514-28 opn 2 hr.
Rec. 260' sw Miss 4746 TD 4945
D&A

ABANDONED



Sec. 13 (Blk. Twp.) 21 (Sur. Rge.) 34W Map No.

Operator **B & R Drig. & NCRA**

Well No. **1** Farm **O'Brien**

Elev.	2914	Location	SE SE SE
-------	------	----------	----------

FIRST REPORT

330 Ft. From S Line SE

330 Ft. From E Line Quarter

1st Report FEB 20 1952

1st. Report FEB 26 1962

Completion

Completion _____

Remarks Parhandle & Shallow

Remarks			
Water - support			

0 15 50

Spudding Date 2-15-54

Drlg. Data Wildcat

8" @ 272 272 3220

0 272 1118 1220


1000

J. C. M. GELIEF

J. G. McGEHEE

J. G. McGEHEE

County Finney State Kansas
 Sec. 13 (Blk. 21) (Sur. 34W) Map No. 21
 Operator B & R Drlg. & NCRA
 Well No. 1 Farm O'Brian
 Elev. 2914 Location SE SE SE

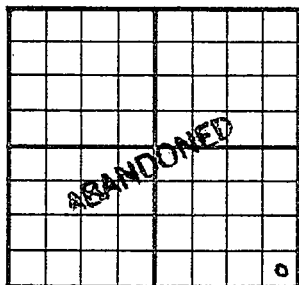330 Ft. From S Line SE330 Ft. From E Line Quarter

1st. Report

Completion MAR 1 9 1952Remarks WildcatSpudding Date 2-15-52Drlg. Data D & A TD 4945

8" @ 272 Hol. 2522 Her. 2553

Kri. 2574 DST 2553-2609 open 1 hr.

Rec. 75' mud 238,000 gas Win. 2613

DST 4180-4224 open 1 hr. Rec. 2290' sw

DST 4384-4408 open 2 hr. Rec. 20' mud

Heeb. 3808 DST-4461-80 open 2 hr.

Rec. 1200' sw DST 4514-28 open 2 hr.

Rec. 260' sw Miss. 4746 TD. 4945

D. & A

J. G. McGEHEE