


Well No. #1 Krey

Company Petroleum Inc.

NORTH

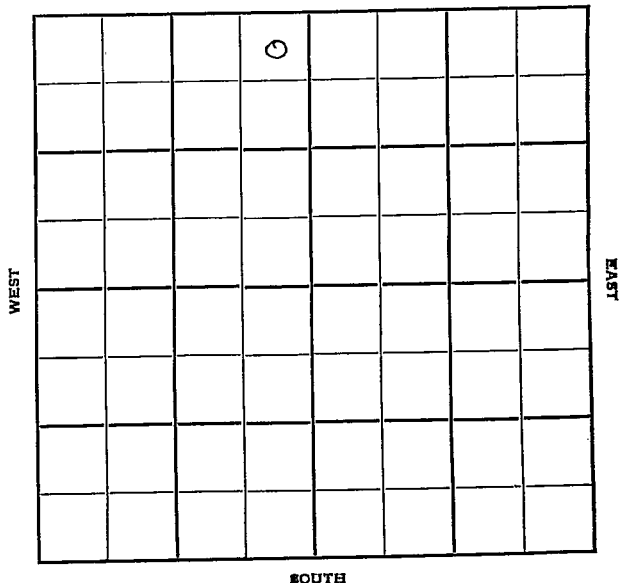

Stafford

KANSAS



14

21

13W

Sec. _____ Twp. _____ R. _____

#1 Krey

Well No. _____ Farm _____

Petroleum, Inc.

Company _____

Garvey

Contractor _____

330


Ft. from N. Line

Ft. from S. Line

330

Ft. from E. Line

Ft. from W. Line

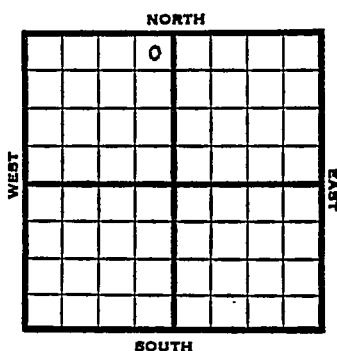NW $\frac{1}{4}$ NE NE NW

1952

Elev. 1869: REPORT

11/5 Spud 10-30-52

8" @ 215'

Anhy 716'

Drlg. 2625'

11/12 Spud 10-30-52

D&A

TD 3605'

8" @ 215'

Anhy 716, Heeb 3141, Br lime
3268', Lans 3286, Simp 3544

Arb 3599

TD 3605

D&A

ABANDONED

County Stafford State Kansas
 Sec. 14 (Blk.) 21 (Sur.) 13W Map No.

Operator Petroleum Inc.

Well No. 1 Farm Krey

Elev. Location NE NE NW

			0				

FIRST REPORT

330 Ft. From W Line NW

330 Ft. From E Line Quarter

1st. Report NOV 5 1952

Completion

Remarks

Garvey - Contr.

Spudding Date 10-30-52

Drlg. Data

8" @ 215 Anhy 716 drlg. 2625

J. G. McGEHEE

County Stafford State Kansas
 Sec. 14 (Blk. 21 (Sur. 13W Map No.
 (Twp.) (Rge.)
 Operator Petroleum Inc.
 Well No. 1 Farm Krey
 Elev. 1869 Location NE NE NW

			6				

ABANDONED

330 Ft. From N Line NW
330 Ft. From E Line Quarter
1st. Report
Completion NOV 12 1952
Remarks
Garvey - Contr.
Spudding Date 10-30-52

Drlg. Data D & A TD 3605
8" @ 215 Anhy 716 Heeb. 3141
Br. lime 3268 Lans. 3286 Simp. 3544
Arb. 3599 TD 3605
D & A

J. G. McGEHEE