

FORM 51 25M 3-49 PETROL

Section 14 Township 21 Range 13M

Well No. #1 Rothbarn

Company Petroleum

Wildcat

NORTH

| | | | | | | | |
|--|--|--|--|--|---|--|--|
| | | | | | | | |
| | | | | | | | |
| | | | | | | | |
| | | | | | | | |
| | | | | | | | |
| | | | | | | | |
| | | | | | 0 | | |
| | | | | | | | |

WEST

EAST

SOUTH

Sec. 14 Twp. 21 R. 13W

Well No. #1 Rothbarn Farm
Petroleum, Inc. Company

Wildcat (Drillers, Contr.) NORTH


_____ Ft. from N. Line

990' Ft. from S. Line

_____ Ft. from E. Line

990' Ft. from W. Line

NE SW SE

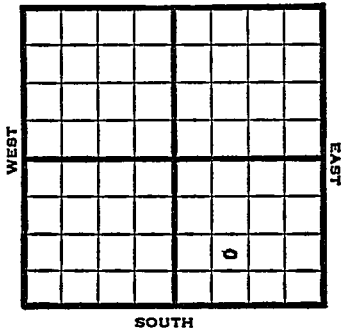

1949 Elev 1867' REPORT

12/21 8" @ 235'
Anhy 842'
Drlg. 2660'
12/28 Lansing 3285'
Arb. 3584'
TD 3597'
5" @ 3590

1950
1/11 TD 3608'
8" @ 235'
5" @ 3590'
D&A
Aband.
Anhy 842'
Br L 3268'
Lan 3285'
Viola 3527'
Simp 3539'
Arb. 3584'
Aband.

ABANDONED

Kansas

Map No. _____ Sec. 14 Twp. 21 R. 13W

Well No. 1 Rothbarn

Petroleum Inc.

Company

Drillers Gas

Contractor

NE SW SE

FIRST REPORT
SECTION FLAT

_____ Ft. from N. Line

990 Ft. from S. Line

_____ Ft. from E. Line

990 Ft. from W. Line

| | | | |
|--|--|---|--|
| | | | |
| | | | |
| | | | |
| | | o | |

Stafford County

Location _____

Rig up _____

Drilling and Remarks:

8" @ 235

Anhy 842

drlg. 2660

RECORD

Cased _____ in., _____ ft.

Sand _____

Gas _____

Oil _____

Total Depth _____

PRODUCTION

1st 24 hrs. Nat. _____

1st 24 hrs. after shot _____

Gas _____ Cu. Ft.

Dry Hole _____

Abandoned _____

Date

DEC 21 1949 19

S. J. LEWIS Scout

DEC 23 1949

Scout Cards

Land Small Map

Land Wall Map

Tracings

.....

.....

.....

.....

.....

Map No. _____ Sec. 14 Twp. 21 R. 13W

Well No. 1 Rothbarn _____

Petroleum Inc. _____ Company

Contractor

NE SW SE


6 lo-1867
SECTION PLAT

_____ Ft. from N. Line

990 Ft. from S. Line

_____ Ft. from E. Line

990 Ft. from W. Line

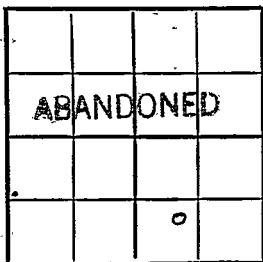

Stafford County

RECORD

Location _____

Cased _____ in., _____ ft.

Rig up _____

Sand _____

Drilling and Remarks:

Gas _____

Oil _____

Total Depth ~~3520~~ 36088" @ 235
5" @ 3590

D & A

PRODUCTION

1st 24 hrs. Nat. _____

1st 24 hrs. after shot _____

Gas _____ Cu. Ft.

Dry Hole _____

Abandoned _____

Date

JAN 11 1950

J. E. TYRA

19

Scout

Ank 842
 Br L 3268
 Jan 3285
 Viola 3527
 Simp 3539
 Arb 3584

JAN 16 1950

| | |
|----------------|--------------|
| Scout Cards | <i>Edith</i> |
| Land Small Map | |
| Land Watl Map | <i>3</i> |
| Tracings | |
| France Map | |
| Pierce Map | |
| Misc. | |