


Stafford

Section 14 Township 21 Range 13W

Well No. #1 Rothgarn

Company Brooks Pierce

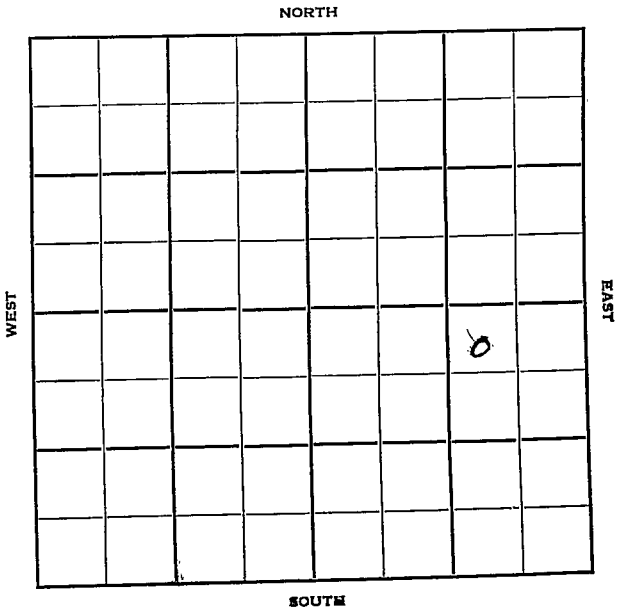

Stafford **KANSAS** ✓

Sec. 14 Twp. 21 R. 13W

Well No. #1 Rothgarn Farm _____
Brooks Pierce Company _____


Contractor Wildcat

330 Ft. from N. Line

_____ Ft. from S. Line

990 Ft. from E. Line

_____ Ft. from W. Line

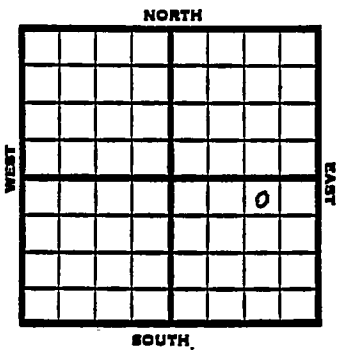

NW NE SE
 Gulf Farmout E/2

1953 Elev. 1866' **REPORT**

3/18 Location

3/26 "

4/2 8" @ 255

Drlg 3000

4/8 SI mud 3-24-53 D & A TD 3650'

8" @ 255 Heeb 3137 Br. lime 3271

Lans. 3283

DST 3293-3322 open 1/2 hr. rec 60' 0 &

GCM 1260# Arb. 3569

DST 3570-81 open 3/4 hr. rec 30' mud

DST 3580-3610 open 1 hr. rec 60' mud
 230#

DST 3610-50 open 1 hr. rec 30' mud

255#

TD 3650' D & A

ABANDONED

County Stafford State Kansas

Sec. 14 (Blk. Twp.) 21 (Sur. Rge.) 13W Map No.

Operator Brooks Pierce

Well No. 1 Farm Rothgarn

Elev. Location NW NE SE

330 Ft. From N Line SE

990 Ft. From E Line 1953 Quarter

1st. Report MAR 18 1953

Completion

Remarks Gulf farmout E/2

Spudding Date

Drlg. Data Wildcat

Location

County Stafford State Kansas

Sec. 14 (Blk.) 21 (Sur.) 13W Map No.

Operator Brooks Pierce

Well No. 1 Farm Rothgarn

Elev. 1866 Location NW NE SE

330 Ft. From N Line SE

990 Ft. From E Line Quarter

1st. Report

Completion APR 8 1953

Remarks Wildcat

Spudding Date 3-24-53

Drilg. Data D & A TD 3650

8# @ 255 Heeb. 3137 Br. lime 3271

Lans. 3283 DST 3293-3322 open 1/2 hr.

Rec. 60' o & gcm 1260# Arb. 3569

DST 3570-81 open 3/4 hr. Rec. 30' mud

DST 3580-3610 open 1 hr. Rec. 60' mud

230# DST 3610-50 open 1 hr. Rec. 30'

mud 255# TD 3650

D & A