

Section 14 Township 21 Range 13-W

Well No. #1 Dorman

Company Mallard & Westgate-Greenland

NORTH

							0

WEST

EAST

SOUTH

Sec. 14 Twp. 21 R. 13-W ✓

Well No. #1 Dorman Farm

Mallard & Westgate-Greenland Company

Contractor


990 Ft. from N. Line

Ft. from S. Line

330 Ft. from E. Line

Ft. from W. Line

SE NE NE

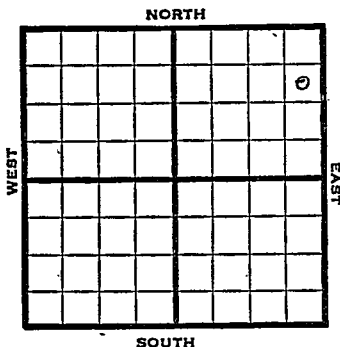

1950

Elev 1867' REPORT

2/15

Spud 2-10-50

8" @ 258'

Drlg 2040'

4/12

TD 3553'

8" @ 258'

Lans 3278'

Arb. 3544'

5½" @ 3546

186 BOPD

Comp

COMPLETED

Map No. _____ Sec. 14 Twp. 21 R. 13W

Well No. 1 Dorman

Mallard & Westgate-Greenland Company

Contractor

SE NE NE

SECTION PLAT

990 Ft. from N. Line

_____ Ft. from S. Line

330 Ft. from E. Line

_____ Ft. from W. Line

				o

FIKST REPORT

Stafford County

Location _____

Rig up _____

Drilling and Remarks:

Spud 2-10-50

8" @ 258

drlg. 2040

RECORD

Cased _____ in., _____ ft.

Sand _____

Gas _____

Oil _____

Total Depth _____

PRODUCTION

1st 24 hrs. Nat. _____

1st 24 hrs. after shot _____

Gas _____ Cu. Ft.

Dry Hole _____

Abandoned _____

Date

FEB 15 1950 19

J. E. TYRA Scout

Kansas

Map No. _____ Sec. 14 Twp. 21 R. 13WWell No. 1 DormanMallard & Westgate-Greenland Company

Contractor

SE NE NE

E/ 1867
SECTION PLAT990 Ft. from N. Line

_____ Ft. from S. Line

330 Ft. from E. Line

_____ Ft. from W. Line

Stafford County

COMPLETE			0

Location _____

Rig up _____

Drilling and Remarks:

8" @ 258
Loss 3278
and 3544
5 1/2" @ 3546
186 BOPD

RECORD

Cased _____ in., _____ ft.

Sand _____

Gas _____

Oil _____

Total Depth 3553

PRODUCTION

1st 24 hrs: Nat. _____

1st 24 hrs. after shot _____

Gas _____ Cu. Ft.

Dry Hole _____

Abandoned _____

Date

APR 12 1950 19J. E. TYRA

Scout