


Section 14 Township 21 Range 13W

Well No. #2 Doran

Company Westgate Greenland et al

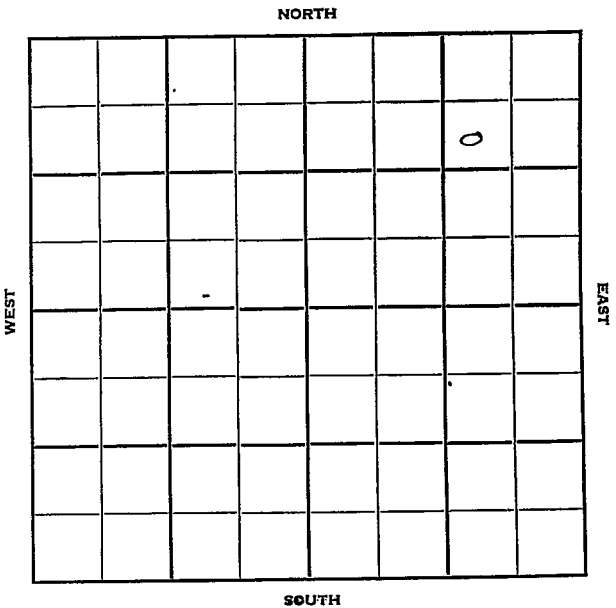

Stafford

KANSAS

Sec. 14 Twp. 21 R. 13W

Well No. #2 Doren Farm

Westgate Greenland et al Company

Mallard - Contr. Contractor


990' Ft. from N. Line

\_\_\_\_\_ Ft. from S. Line

990' Ft. from E. Line

\_\_\_\_\_ Ft. from W. Line

SW NE NE

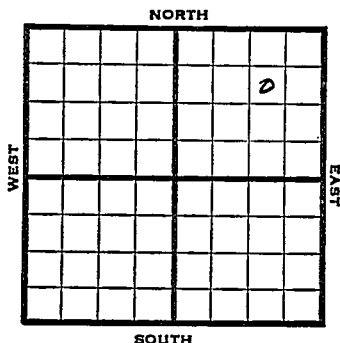

1952 Elev. 1866' REPORT

2/6 Spud 2-2-52  
8" @ 252  
Drlg. 1275'

2/20 Heeb 3137 Br Li 3263  
Lans. 3279 Arb. 3549  
DST 3550-60 1 hr. 335' clean oil  
60' muddy oil #1050 bhp TD 3560  
5" @ 3550 DP CO to 3560 fill up  
3000' oil 20 hrs. to A 500

3/5 POP

3/11 "

3/19 Spud 2-2-52 Oil Well TD 3560  
8" @ 252 Heeb. 3137 Br Lime 3263  
Lans. 3279  
DST 3304-55 opn 1 hr. Rec. 30' mud  
DST 3396-3408 opn 1 hr. Rec. 90' mud  
Arb. 3549 DST 3550-60 opn 1 hr.  
Rec. 335' clean oil 60' muddy oil  
TD 3560 5" @ 3550 CO to 3560  
FU 3000' oil 20 hr. 500 A  
S/30 boph 6 hr. Comp. 408 bopd

**COMPLETED**



