


FORM 51 **Stafford**

KANSAS

Section 14 Township 21 Range 13W

Well No. 5 Doran

Company Westgate-Greenland

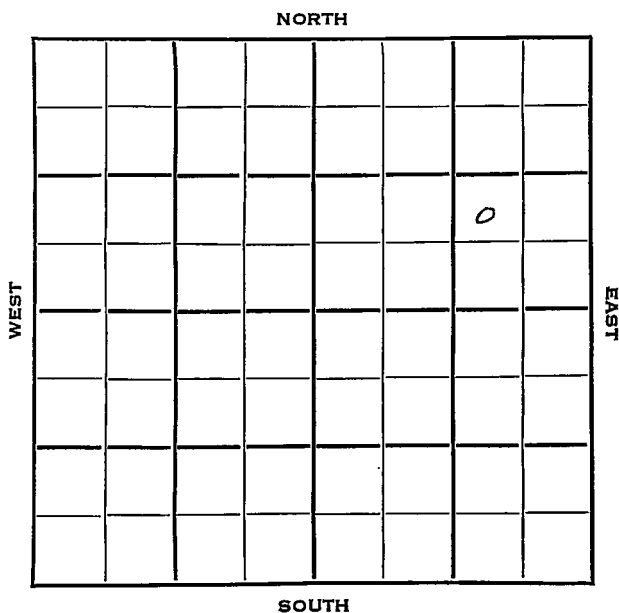

KANSAS ✓

Stafford

Sec. 14 Twp. 21 R. 13WWell No. 5 Doran FarmWestgate-Greenland Company


Contractor

Ft. from N. Line

940 Ft. from S. Line990 Ft. from E. Line

Ft. from W. Line

NW SE NE

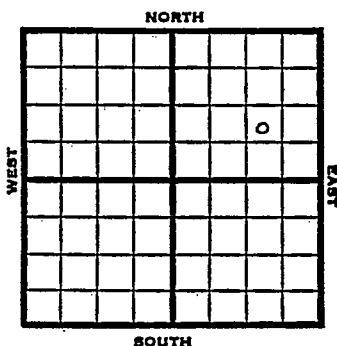

1953

Elev. 1865 REPORT

1/7

Spudding Date 1/1/53
10" @ 201 Drlg. 2550

1/22

Drlg. 2550'

1/29

POP

2/5

"

2/11

Spudding date 1/1/53

Oil well TD 3583

10" @ 201 Heeb. 3118 Br. Lime 3251

Lans. 3264 DST 3286-3306 gas in 23

min. open 1 hr. Rec. 1260' gassy

oil 1160# DST 3325-38 open 1 hr.

Rec. 2235' gassy oil 60' ocm 1240#

DST 3377-3403 open 1 hr. F/3412'

gassy oil 1170# Arb. 3512 TD 3583

7" @ 3582 95/3378-3402 FU 1000'

oil 5 hr. S/45 bo 6 hr. 1000A S/24 boph
4 hr. F/25 boph 5 hr. Comp. 466
bopd.

COMPLETED


J. G. McGEHEE

Scout Cards	
Land Small Map	
Land Wall Map	
Tracings	
France Map	
Pierce Map	
MISC.	

JAN 14 1952

Drig. Date

County Stafford State Kansas
 Sec. 14 (Blk. 21) (Sur. 13W) (Rge.) Map No.
 Operator Westgate-Greenland
 Well No. 5 Farm Doran
 Elev. 1865 Location NW SE NE

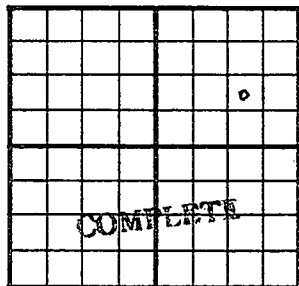

940 Ft. From S Line NE

990 Ft. From E Line Quarter

Ist. Report

FEB 11 1953

Completion

Remarks

Spudding Date

1-1-53

Drlg. Data Oil well TD 3583
10" @ 201 Heeb. 3118 Br. line 3251
Lans. 3264 DST 3286-3306 gas in 23 min.
open 1 hr. Rec. 1260' gassy oil 1160#
DST 3325-38 open 1 hr. Rec. 2235' gassy
oil 60' ocm 1240# DST 3377-3403 open
1 hr. F/ 3412' gassy oil 1170#
Arb. 3512 TD 3583 7" @ 3582 95/ 3378-
3402 FU 1000' oil 5 hr. S/ 45 bo 6 hr.
1000 A S/ 24 boph 4 hr. F/ 25 boph 5 hr.
Comp. 466 bopd

J. G. McGEHEE

Scout Cards

Land Small Map

and Wall Map

acings

.. 3 Map

3 Map

FEB 18 1953

Orig. Date