

Sec. 14 Twp. 21 R. 13W

Well No. 1 Krey Farm _____

York State Company _____


Rothgarn Pool

330 Ft. from N. Line

_____ Ft. from S. Line

~~990~~ Ft. from E. Line

990 Ft. from W. Line

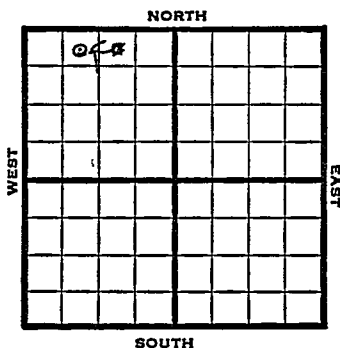

~~NW NE NW~~

Yes New NW

REPORT

1948

Eli 1873'

11/17

8" @ 256'
Drlg. 1650'

11/23

Drlg 3270'

12/1

TD 3912'
Lansing 3290'
Arb. 3873'
Aband.

ABANDONED

Map No. _____ Sec. 14 Twp. 21 R. 13W

Well No. 1 Krey

York State

Company _____

FIRST REPORT

Contractor _____

NW NE NW

SECTION PLAT

330 Ft. from N. Line

_____ Ft. from S. Line

990 Ft. from E. Line

_____ Ft. from W. Line

	6		

Stafford County

Location _____

Rig up _____

Drilling and Remarks:

8" @ 256

drlg. 1650

RECORD

Cased _____ in., _____ ft.

Sand _____

Gas _____

Oil _____

Total Depth _____

PRODUCTION

1st 24 hrs. Nat. _____

1st 24 hrs. after shot _____

Gas _____ Cu. Ft.

Dry Hole _____

Abandoned _____

Date

NOV 17 1948 19

S. J. LEWIS Scout

Map No. 82 Sec. 14 Twp. 21 R. 13W

Well No. 1 Krey

York State Company

CORRECTION Contractor

NE NW NW

SECTION PLAT

330 Ft. from N. Line

_____ Ft. from S. Line

_____ Ft. from E. Line

990 Ft. from W. Line

o			

Stafford County

Location _____

Rig up _____

Drilling and Remarks:

Reported

NW NE NW

RECORD

Cased _____ in., _____ ft.

Sand _____

Gas _____

Oil _____

Total Depth _____

PRODUCTION

1st 24 hrs. Nat. _____

1st 24 hrs. after shot _____

Gas _____ Cu. Ft.

Dry Hole _____

Abandoned _____

Date

DEC 1 1948 19

S. J. LEWIS

Scout

Kansas

Map No. 82 Sec. 14 Twp. 21 R. 13W

Well No. 1 Krey

York State Company

ABANDONED Contractor

NE NW NW

E. 11/873
SECTION PLAT

330 Ft. from N. Line

_____ Ft. from S. Line

_____ Ft. from E. Line

990 Ft. from W. Line

o			

Stafford County

Location _____

Rig up _____

Drilling and Remarks:

Liams 0290

CR 43873

RECORD

Cased _____ in., _____ ft.

Sand _____

Gas _____

Oil _____

Total Depth 3912

PRODUCTION.

1st 24 hrs. Nat. _____

1st 24 hrs. after shot _____

Gas _____ Cu. Ft.

Dry Hole _____

Abandoned _____

Date

DEC 1 1948 19.

S. J. LEWIS Scout