FORM 51 25M 3-49 PETROL

KANSAS

Stafford

Section 14 Township 21 Range 14W

Well No. #1 Curtis

Company CharlesHulme

NORTH

WEST

EAST

SOUTH

FORM 252-B

Stafford KANSAS

Sec. 14 Twp. 21 R. 14W

Well No. #1 Curtis Farm

Charles Hulme Company

Contractor

330 Ft. from N. Line

Ft. from S. Line

330 Ft. from E. Line

Ft. from W. Line

NE NE NW

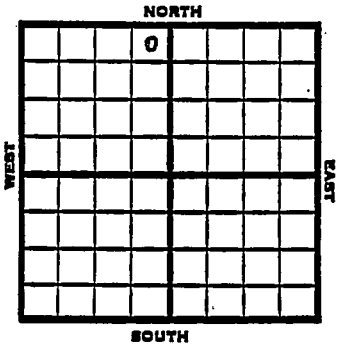

1953	Elev. 1924' REPORT
3/18	Spud 3-12-53 8" @ 310 Anhy 790 Drlg. 1987'
3/26	Drlg. 3575'
4/1	Spud 3-12-53 D & A TD 3760' 8" @ 310' Anhy 790 Heeb 3255 Br lime 3372 Lans. 3382 Cong. 3641' Viola 3649 Simp. 3677 DST 3649-81 open 1 hr. rec 12' mud 30# Arb. 3718' TD 3760' D & A **ABANDONED**

FORM 275 FOR SALE BY KANSAS BLUE PRINT CO.

County Stafford State Kansas

Sec. 14 (Blk. Twp.) 21 (Sur. Rge.) 14W Map No.

Operator Charles Hulme

Well No. 1 Farm Curtis

Elev. 1924 Location NE NE NW

			0				

FIRST REPORT

330 Ft. From N Line NW

330 Ft. From E Line Quarter

1st. Report MAR 18 1953

Completion

Remarks

Spudding Date 3-12-53

Drlg. Data

8" @ 310 Anhy 790 drlg. 1987

J. G. McGEHEE

FORM 275 FOR SALE BY KANSAS BLUE PRINT CO.

County Stafford State Kansas

Sec. 14 (Blk. Twp.) 21 (Sur. Rge.) 14W Map No.

Operator Charles Hulme

Well No. 1 Farm Curtis

Elev. 1924 Location NE NE NW

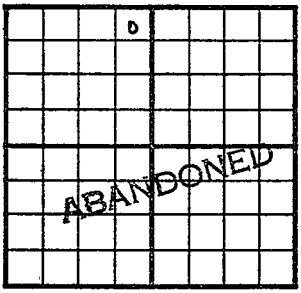

330 Ft. From N Line NW

330 Ft. From E Line Quarter

1st. Report

Completion APR 1 1953

Remarks

Spudding Date 3-12-53

Drlg. Data D & A TD 3760

8" @ 310 Anhy 790 Heeb. 3255

Br. lime 3372 Lans. 3382 Cong. 3641

Viola 3649 Simp. 3677 DST 3649-81

open 1 hr. Rec. 12' mud 30# Arb. 3718

TD 3760

D & A

J. G. McGEHEE