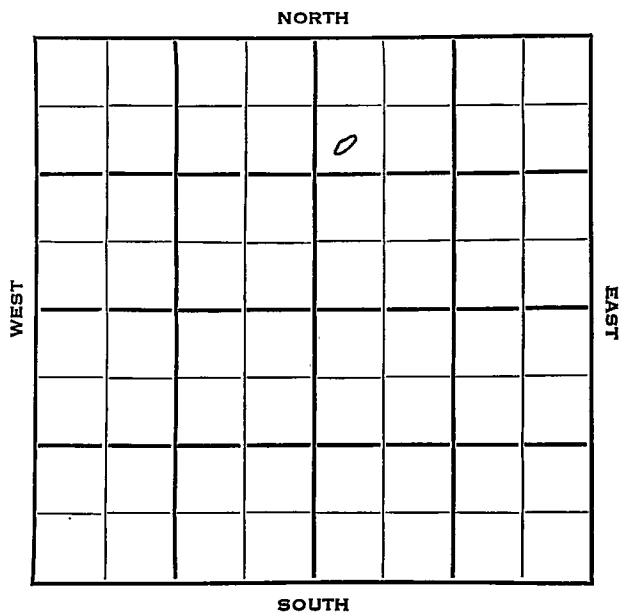


Section 14 Township 21 Range 15WWell No. #1 ConverseCompany Vickers Petroleum Company

Pawnee **KANSAS** ✓Sec. 14 Twp. 21 R. 15 WWell No. # 1 Converse FarmVickers Pet.

Company

Jayhawk Drlg.

Contractor

Wildcat990

Ft. from N. Line


Ft. from S. Line

Ft. from E. Line

330

Ft. from W. Line

SW NW NE

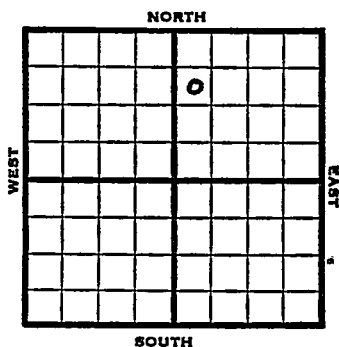

1953

Elev. 1947' REPORT

3/11

Location

3/19

Anhy 904
Drlg. 908'


3/26

Drlg. 3010'

4/1

Spud 3-16-53 D & A TD 3845'
 8" @ 909 Anhy 904 Heeb 3303
 Br line 3405 Lans 3414 Viola 3687
 Simp. 3747
 DST 3418-47 open $\frac{1}{2}$ hr, rec 8' mud
 Arb. 3795 TD 3845'
 D & A

ABANDONED

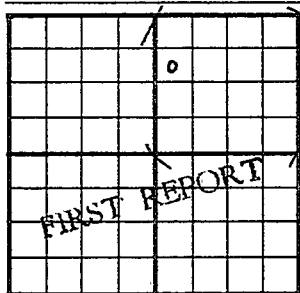County Pawnee State KansasSec. 14 (Blk. Twp.) 21 (Sur. Rge.) 15W Map No.Operator Vickers Pet.Well No. 1 Farm ConverseElev. Location SW NW NE990 Ft. From N Line NE330 Ft. From W Line Quarter1st. Report MAR 11 1953

Completion


Remarks

Jayhawk Drlg. - Contr.

Spudding Date

Drlg. Data WildcatLocation

J. G. McGEHEE

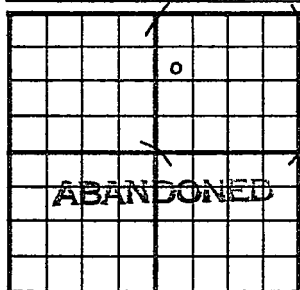County Pawnee State KansasSec. 14 (Blk.
Twp.) 21 (Sur.
Rge.) 15W Map No.Operator Vickers Pet.Well No. 1 Farm ConverseElev. 1947 Location SW NW NE990 Ft. From N Line NE330 Ft. From W Line Quarter

1st. Report

Completion APR 1 1953Remarks WildcatJayhawk Drlg. - Contr.Spudding Date 3-16-53Drlg. Data D & A TD 38458" @-909 Anhy 904 Heeb. 3303Br. lime 3405 Lans. 3414 Viola 3687Simp. 3747 DST 3418-47 open $\frac{1}{2}$ hr.Rec. 8' mud Arb. 3795 TD 3845D & A