


Section 14 Township 21 Range 7WWell No. #1 O'ConnellCompany Jones, Shelburne & Farmer

NORTH

WEST

EAST

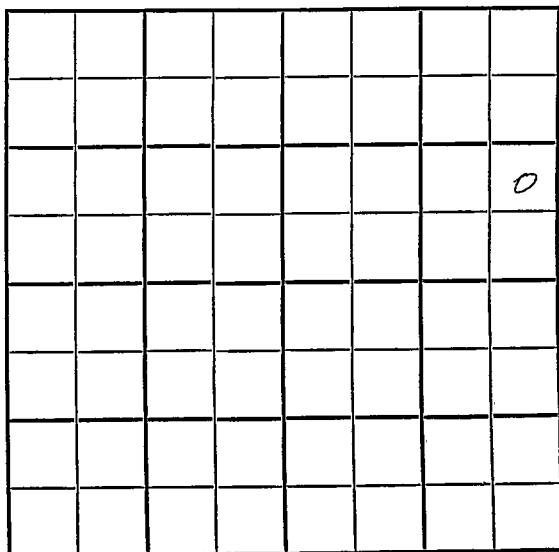

SOUTH

Rice

KANSAS

SEC.	TWP.	R.
14	21	7W

WELL NO.

#1 O'Connell

FARM

COMPANY

Jones, Shelburne & Farmer

CONTRACTOR

Co. Tools

Wherry


____ FT. FROM N. LINE

____ FT. FROM S. LINE

____ FT. FROM E. LINE

____ FT. FROM W. LINE

NE SE NE

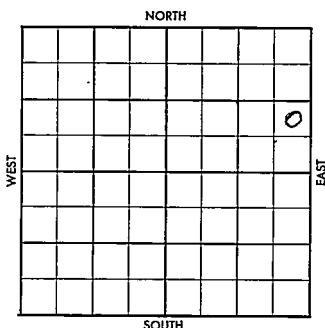

	ELEVATION	REPORT
1956	1598'	
6-6	MIR	
7-11	Comm. 6-4-56 8 5/8" @ 175 w/125 DST 3386-92 op 1 hr, rec. 60' O&GCM / 30' O&GCSW, BHP 330#. DST 3368-85 op 1 hr, gas to surf. in 4 min, ga, 600 MCF, rec. 130' gssy oil / 120 mdy oil, BHP 330 5 1/2" @ 3392 w/15 CO 3384, 32/ 3376-80 S/ 4 GFPH S/ 2 1/2 boph, no/wtr. S/ 4 BOPH no/wtr, P/ 32 BO, no/wtr., 24 hrs., Grav. 37. H. 2681'; L. 2887'; Chert 3367'; TD 3392'	
		COMPLETED

County Rice Elev. _____
 Sec. 11 Twp. 21 Rge. 7W
 Company Jones, Shelburne & Farmer
 Farm Name O'Connell No. 1

TOPS//	DEPTH	LOG	DATUM	Loc. in Sec.
Anh.				NE SE NE
TP.				
H.				
Tr.				
Dg.				
Bl.				
L.				Geol.
K.C.				Contr.
B.K.C.				Co. tools
Ce.				Pool
C.				Wherry
M.				
M.				
K.				
Mz.				
Me.				
V.				
S.				
S.				
A.				
R.				
PE.				
G.				
T.D.				

FIRST REPORT

JUN 6 '58

Date Comm.

M I R

22PM F 8-1411

D.A.

County Price Elev. 1,100
 Sec. 14 Twp. 21 Rge. 7N
 Company Jones, Shelburne & Farmer
 Farm Name O'Connell No. 1

TOPS	DEPTH	LOG	DATUM	Loc. in Sec.
Anh.				15 S 17
Tr.				
H.	2651			
Tr.				
Dg.				
Bl.				
L.	2897			Geol.
K.C.				Contr.
B.K.C.				
Ce.				Co. tool's
C. <u>chert</u>	3367			Pool
M.				Where
M.				
K.				
Mz.				
Me.				
V.				
S.				
S.				
A.				
R.				
Pe.				
G.				
TD.	3392			COMPLETE

Date Comm.

JUL 1 1 1956

M I R JUN 13 '56 Spd 6-4-56 8 1/2 175/115
 p3040 JUN 20 '56 DST 3386-92 1hr
 rec 60' O&G CM + 30' O&G CSW
 BHP 3301 DST (5+ PKV)
 3368-85 1hr 9 to 5. 4" ga
 600 MCF rec 130' 9559 oil + 120
 Mdy oil BHP 330 5 1/2 @ 3392
 175 JUN 27 '56 CO 3384 32/3376-80
 \$ 4 GFph 1/2 \$ 2 1/2 Boph no/w

FORM 513-1 SUNRAY

14-21-7W

NE SE NE

Frac 2x3 \$ 4 Boph nolw

POP JUL 3 '58 JUL 11 '55 P. 32 Bo

nolw to 24 hrs

graw 37°

14-21-17