

Rice

KANSAS

14

21


8W

SECTION _____ TOWNSHIP _____ RANGE _____

WELL NO. #1 Coyne

COMPANY Bennett & Gould

NORTH NE NE NW

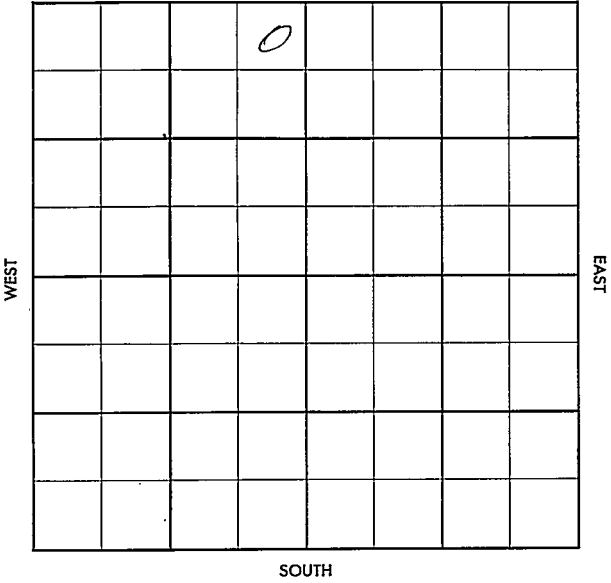

21
~~WILDCAT~~

FORM 513 SUNRAY

County Rice Elev. _____
Sec. 11 Twp. 21 Rgs. 8W
Company Bennett & Gould
Farm Name Coyne No. 1

TOPS	DEPTH	LOG	DATUM
Anh.			
TP.			
H.			
Tr.			
Dg.			
BL.			
L.			
K.C.			
B.K.C.			
Ce.			
C.			
M.			
M.			
K.			
Mz.			
Me.			
V.			
S.			
S.			
A.			
R.			
PE.			
G.			
T.D.			

Loc. in Sec. NE NE NW
Geol. _____
Contr. Cherry
Pool Wildcat
FIRST REPORT

Date Comm. 2-4-57
8" @ 200/165

~~12~~

Co.
Lse.
No.
Sec.
T.
R.

County Rice Elev. 1634 DF
 Sec. 14 Twp. 21 Rge. 8W
 Company Bennett & Gould
 FarmName Coyne No. 1

TOPS	DEPTH	LOG	DATUM
Anh.			
Tp.			
H.	2751		
Tr.	2769		
Dg.	2777		
Bl.	2897		
L.	2936		
K.C.			
B.K.C.	3258		
Ce.			
C.	3324		
M.	3328		
M.			
K.			
Mz.			
Mo.			
V.			
S.			
S.			
A.			
R.			
PE.			
G.			
TD.	3380		

Loc. in Sec. NE NE NW
 Geol. _____
 Contr. Cherry
 Pool Wildcat
 FEB 20 '57
 ABANDONED

Date Comm. 2-1-57
8" @ 200/165 FEB 13 '57 10 5095 FEB 20 '57

DST 3223-55 1hr. rec 20' 50CM
BHP 65/20' FPO

DEU

Co.
 No.
 Sec.
 T.
 R.