

DX 78-1


Rice

KANSAS

Section 14 Township 21 Range 10 W

Well No. # 1 Fair


Company North American Pet.

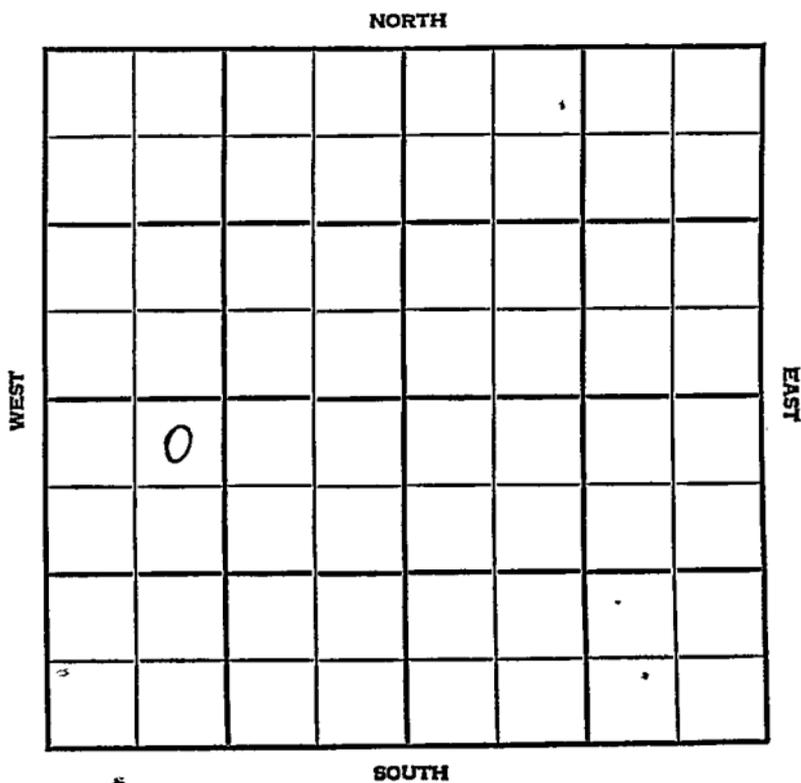

// Rice KANSAS

SEC.	TWP.	R.
14	21	10W
WELL NO.		
1 Fair		FARM
COMPANY		
North American Petr.		
CONTRACTOR		

330 \_\_\_\_\_ Ft. from N. Line  
 \_\_\_\_\_ Ft. from S. Line  
 \_\_\_\_\_ Ft. from E. Line  
 990 \_\_\_\_\_ Ft. from W. Line

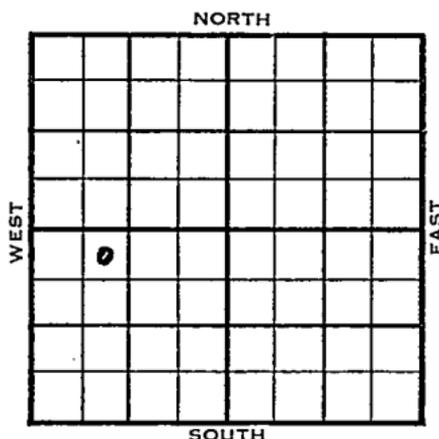

NE NW SW  
 Magnolia AC

1954	ELEVATION	REPORT
	1709'	
10/20		Spud 10-14-54 8" @ 252' Drlg. 2360'
11/3		Spud 10-14-54 - D&A TD 3450' 8" @ 252' Heeb. 2838', Lans 3005' DST 3039-73', opn 1 hr., rec. 30' gas, 90' SO&GCM, 190# DST 3073-3103', opn 1 hr., rec. 190' muddy SW, 1070# Song. 3320' DST 3309-48', opn 1 hr., rec. 50' mud, Simp. 3348' DST 3378-95', opn 1 hr., rec. 30' VSOCM, Arb. 3412' DST 3410-50', opn 1 hr., rec. 2700' SW DST 3185-3202', opn 1 hr., rec. 15' mud D&A

**ABANDONED**



County Rice State Kansas  
 Sec. 14 (Blk. 21) (Sur. 10W) (Twp.) (Rge.) Map No.  
 Operator North American Pet.  
 Well No. 1 Farm Fair  
 Elev. 1709 Location NE NW SW


330 Ft. From N Line SW  
990 Ft. From W Line Quarter  
 Ist. Report  
 Completion NOV 3 1954  
 Remarks  
 Spudding Date 10-14-54

Drlg. Data D & A TD 3450  
8" @ 252 Heeb. 2838 Lans. 3005  
DST 3039-73 open 1 hr. Rec. 30' gas  
90' so & gcm 190# DST 3073-3103  
open 1 hr. Rec. 190' muddy sw 1070#  
Cong. 3320 DST 3309-48 open 1 hr.  
Rec. 50' mud Simp. 3348 DST 3378-95  
open 1 hr. Rec. 30' vsocm Arb. 3412  
DST 3410-50 open 1 hr. Rec. 2700' sw  
DST 3185-3202 open 1 hr. Rec. 15' mud  
D & A

FABEN GILSTRAP