


SECTION 15 14 TOWNSHIP 21S RANGE 11W

WELL NO. #1 Fair

COMPANY Brunson Prod. NW NW SW

NORTH ~~NE NE SE~~

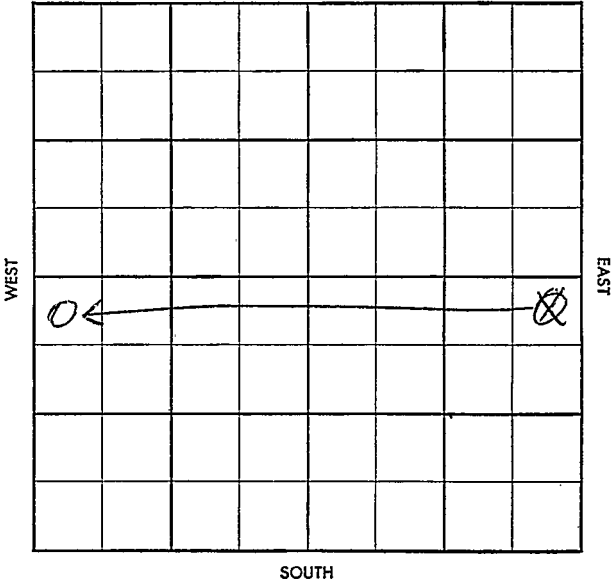

Twp. N R. N
~~Sec. X~~ ~~18~~

S-513-B

County Stafford Elev. _____
 Sec. 15 Twp. 21 Rge. 11W
 Company Brunson Prod.
 Farm Name Fair No. 1

TOPS	DEPTH	LOG	DATUM
Anh.			
Tp.			
H.			
Tr.			
Dg.			
B.L.			
L.			
K.C.			
B.K.C.			
Ce.			
C.			
M.			
M.			
K.			
Mz.			
Mq.			
V.			
S.			
S.			
A.			
R.			
Pf.			
G.			
T.D.			

Loc. in Sec. _____
NE NE SE
 Geol. _____
 Contr. _____
Brunson tool
 Pool _____
Snider So.

MAR 19 1958
FIRST REPORT

Date Comm. _____
WORT

Co.
 L.S.
 No.
 Sec.
 T.
 R.

CORRECTION

~~Section~~
~~Page~~

S-513.B

County Stafford Elev. 17420 F
 Sec. 14 35 Twp. 21 Rge. 11W
 Company Brunson Prod.
 Farm Name Fair No. 1

TOPS	DEPTH	LOG	DATUM
Anh.			
Tp.			
H.	<u>2907</u>		
Tr.	<u>2930</u>		
Dg.			
B.L.	<u>3044</u>		
L.	<u>3060</u>		
K.C.			
B.K.C.			
Ce.			
C.			
M.			
M.			
K.			
Mz.			
Mq.			
V.			
S.			
S.			
A.	<u>3407</u>		
R.			
Pf.			
G.			
T.D.	<u>3421</u>		

in Sec. NE NE SE
~~NE NE SE~~
new new new
 Geol. _____
 Contr. _____
Brunson tool
 Pool W.C.
Snider So.

ABANDONED

APR 16 '58

Date Comm. 3-20-58
 WORT 231/200 ϕ 2950
2930 - 54 op 1hr 30'
OCM 70' SOC WM FPO BHP
905/3, DST 3323-45 op 60"
12' M FPO BHP 13525 DST 3412-2)
op 1hr 2335' SW VSSO
 APR 9 '58 B40 1070.

DFA