


Section 14 Township 21 Range 12W

Well No. 1 Crow

Company Virginia Drlg et al

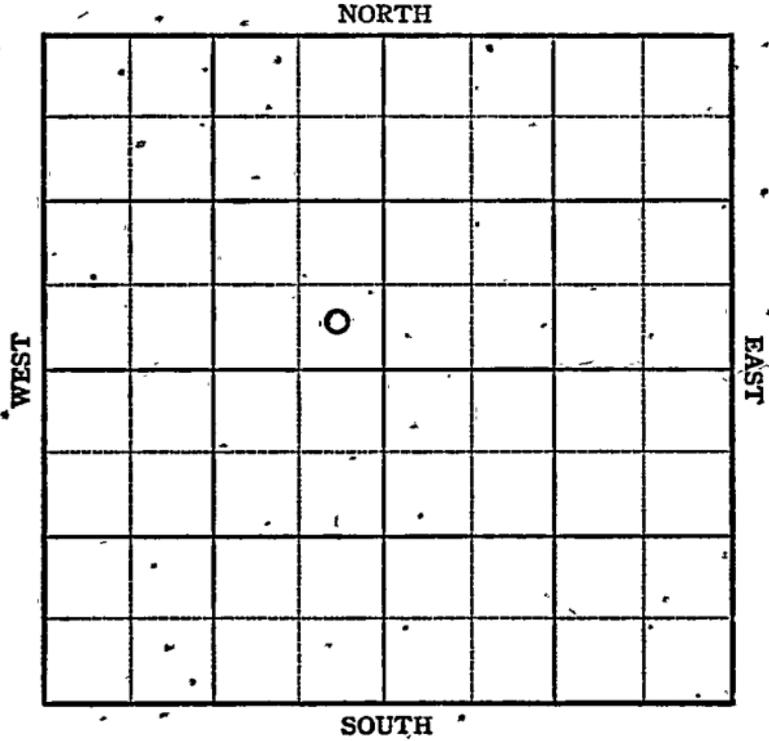

KANSAS

Stafford

Sec. 14 Twp. 21 R. 12-W

Well No. #1 Grow Farm

Virginia Drlg etal Company


Mueller Pool

Ft. from N. Line

330 Ft. from S. Line

330 Ft. from E. Line

Ft. from W. Line

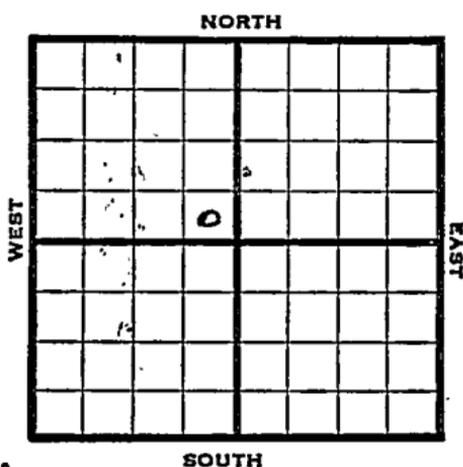

SE NW Elev. 1887'

REPORT

1947

3/12 8" @ 300'
Anhy 620
Drlg 945'

3/18 Topeka 2780'
Drlg 3000'

3/25 Lans 3229
Viola 3470
Simp 3498
Arb 3439-45 ?
TD 3545'
5" @ 3541
RUST

4/2 " "

4/9 TD 3561'
1000 Acid.

4/15 2000 Acid
TD 3580'

4/23 2000 Acid
Swb 3 hbls oil PH

4/29 30 qts 3555-80
CO

5/7 1000' acid

5/13 " "

OVER

5/20 1000 Acid

5/27 " "

6/4 Arb. 3539'
5" @ 3541'
Pump 87 Oil 46% W pot
40.0 Gr.
TD 3580'

COMPLETED