

KANSAS

FORM 51 5M 6-46 PETROL


O. W. P. B.

Stafford

Section 14 Township 21 Range 12W

Well No. 2 Roberts

Company Virginia Drlg. etal

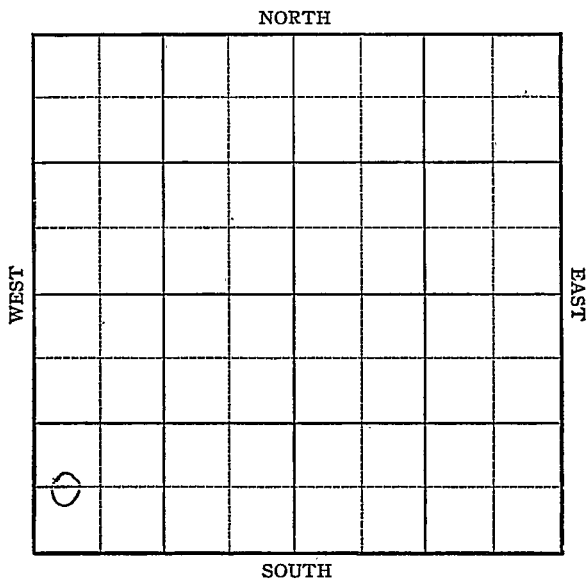

KANSAS

Stafford County

Sec. 14 Twp. 21 R. 12W ✓Well No. #2 Roberts Farm _____

Virginia Drlg. et al Company _____

Wildcat
SOUND A O. W. P. B.


_____ Ft. from N. Line

660 _____ Ft. from S. Line

_____ Ft. from E. Line

330 _____ Ft. from W. Line

CWL SW SW

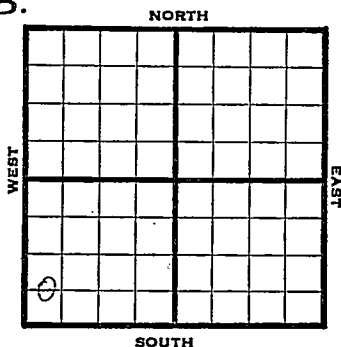

1946

1837

REPORT

7/3

10" @ 340
Topeka 2772'
Lans 3229
Cong. 3477
Smy Sh. 3508
Smp. Sd. 3543
Arb. 3546
TD 3551
5" @ 3547 RUST

7/9

" "

7/16

3559-250 acid
1½ bail in 12 hrs

7/23

TD 3569
500 acid SSO

7/30

20 qts 3555-69
1000 acid, 200' oil in 27 hrs

8/6

TD3584
1000 acid, swb 7 oil PH

8/13

TD 3602
swb 2 oil PH

8/20

Pump 19 oil in 8 hrs

8/27

" " "

9/5

" " "

9/10

Pump 122 oil in 24 hrs

9/18

70' of 4" liner @ 3602'
Pump 97 oil in 24 hrs

9/24

" " "

10/1

Drlg 4667'

10/8

" "

OVER

1946

10/15 70' of 4" liner @ 3602'
Pump 87 oil in 24 hrs

10/22 " " "

10/29 " " "

11/6 Arb 3546'
5" @ 3547'
TD 3569'
5000 Acid
Pump 24 POT
Grav. 33

COMPLETED

1950

O. W. P. B.

8/30 Lans. 3229'
OTD 3602'
5" @ 3547'
Was Arb.prod.
PB 3350'
46/3277-94

Testing

9/27 Lans 3229
OTD 3602
5" @ 3547
PB 3350
46/3277-94
Comp 6 bopd
TD 3350
Completed

COMPLETED

KANSAS

Kansas Pool Name WildcatMap No. 76 Sec. 14 Twp. 21 R. 12WWell No. 2 RobertsVirginia Drlg. etal.


Company

FIRST REPORT

Contractor

C W L SW SW

SECTION PLAT

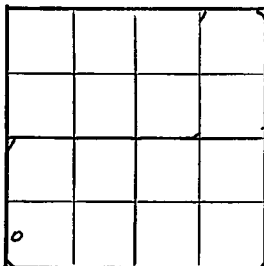 Ft. from N. Line660 Ft. from S. Line Ft. from E. Line330 Ft. from W. LineStafford CountyLocation Rig up

Drilling and Remarks:

10"@340'

Topeka 2772'

Lans. 3229'

Cong. 3477'

Smy. Sh. 3508'

Smp.Sd. 3543'

Arb. 3546'

T.D. 3551 - 5"@

3547' Rust.

RECORD

Cased in., ft.Sand Gas Oil Total Depth

PRODUCTION

1st 24 hrs. Nat. 1st 24 hrs. after shot Gas Cu. Ft.Dry Hole Abandoned

Date

JUL 3 1946 19S. J. LEWIS

Scout

KANSAS

Form 26 200 Bks. 10-46 Petrol

Kansas

Wildcat

Map No. 46 Sec. 14 Twp. 21 R. 12WWell No. 2 RobertsVirginia Drlg. etal. Company**COMPLETED**

Contractor

C W L SW SW

E. I. S.?
SECTION PLAT

4			

 Ft. from N. Line660 Ft. from S. Line Ft. from E. Line330 Ft. from W. Line

Stafford County

Location Rig up

Drilling and Remarks:

Per 43546
5' casing
5000 acid
Aug 24 1946

230 ft

RECORD

Cased in., ft.Sand Gas Oil Total Depth 2539

PRODUCTION

1st 24 hrs. Nat. 1st 24 hrs. after shot Gas Cu. Ft.Dry Hole Abandoned

Date

NOV 6 1946 19

S. J. LEWIS Scout

O W D B.

County Stafford State KansasSec. 14 (Blk. Twp.) 21 (Sur. Rge.) 12W Map No.Operator Virginia Drlg.Well No. 2 Farm RobertsElev. 1837 Location C W L SW SW

660 Ft. From S Line SW330 Ft. From W Line Quarter1st. Report AUG 30 1950


Completion

Remarks

Spudding Date

Drlg. Data Saundra PoolLaps. 3229 OTD 3602 5" @ 3547was Arb. prod. PB 3350 46/ 3277-94testing

J. E. TYRA

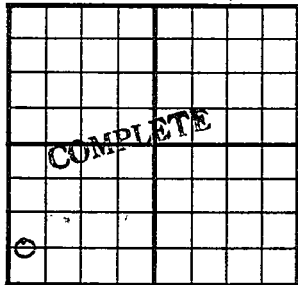County Stafford State KansasSec. 14 (Blk.
Twp.) 21 (Sur.
Rge.) 12W Map No.Operator Virginia Drlg.Well No. 2 Farm RobertsElev. 1837 Location C W L SW SW660 Ft. From S Line SW330 Ft. From W Line Quarter1st. ReportCompletion SEP 27 1950Remarks Saundra PoolOWWOSpudding DateDrlg. Data Oil well TD 3350Lans. 3229 OTD 3602 5" @ 3547PB 3350 46/ 3277-94 Comp. 6 bopd