


Section 14 Township 21 Range 12-W

Well No. #3 Roberts

Company Virginia Drlg.

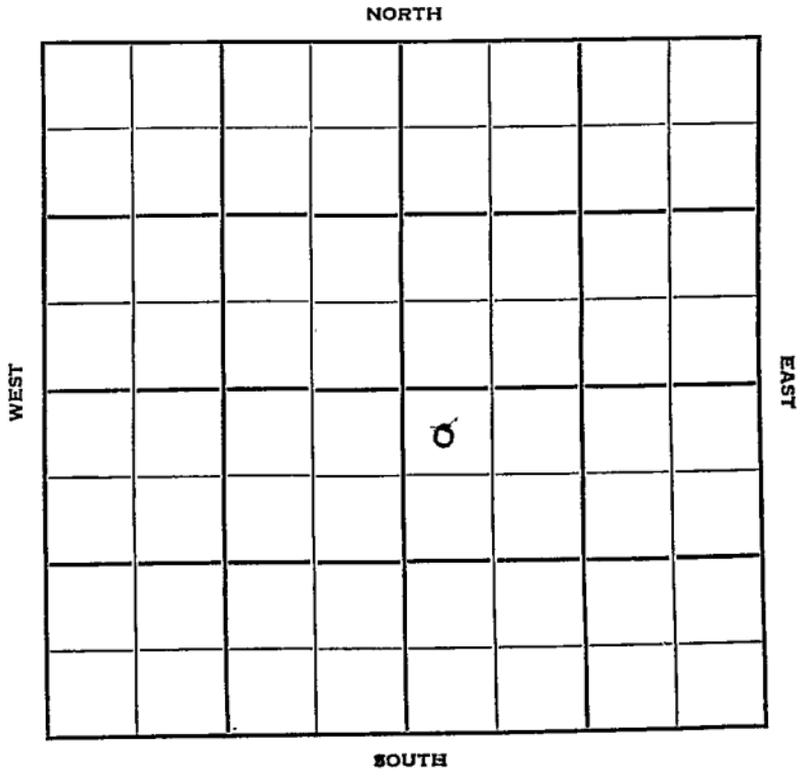

Sec. 14 Twp. 21 R. 12W

Well No. #3 Roberts Farm

Virginia Drlg. Company

Contractor

**Sandra Pool**


330' Ft. from N. Line

\_\_\_\_\_ Ft. from S. Line

\_\_\_\_\_ Ft. from E. Line

330' Ft. from W. Line

NW NW SE

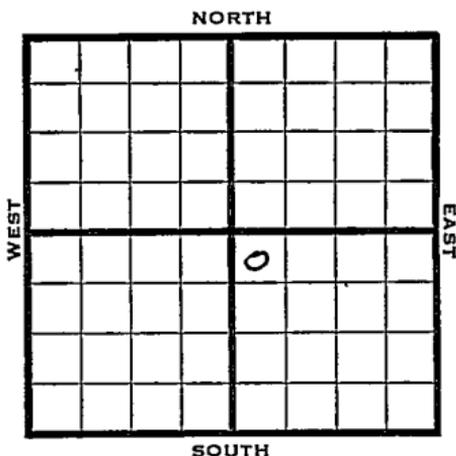

1950 Elev. 1841' REPORT

8/9 Location

12/6 Oil Well TD 3602  
 8" @ 286' Anhy 635'  
 Lans. 3228'  
 DST 3260-99 opn 45min Rec. 30'ocm  
 Conç. 3476 Viola 3516' Simp 3544  
 Arb. 3582' TD 3602 5" @ 3586  
 2 go 2000 A FU 350' oil overnitê  
 S/5 boph Comp. 2 bopd  
**COMPLETED**



County Stafford State Kansas

Sec. 14 (Blk. 21) (Sur. 12W) (Twp.) (Rge.) Map No.

Operator Virginia Drlg.

Well No. 3 Farm Roberts

Elev. 1841 Location NW NW SE


330 Ft. From N Line SE

330 Ft. From W Line Quarter

1st. Report

Completion DEC 6 1950

Remarks Sandra Pool

Spudding Date

Drlg. Data Oil well TD 3602

8" @ 286 Anhy 635 Lans. 3228

DST 3260-99 open 45 min. Rec. 30' ocm

Cong. 3476 Viola 3516 Simp. 3544

Arb. 3582 TD 3602 5" @ 3586 2.g.o.c.

2000 A FU 350' oil overnite

S/ 5 boph Comp. 2 bopd

J. E. TYRA