


Section 14 Township 21 Range 16W

Well No. #1 Wedel

Company Carl Todd

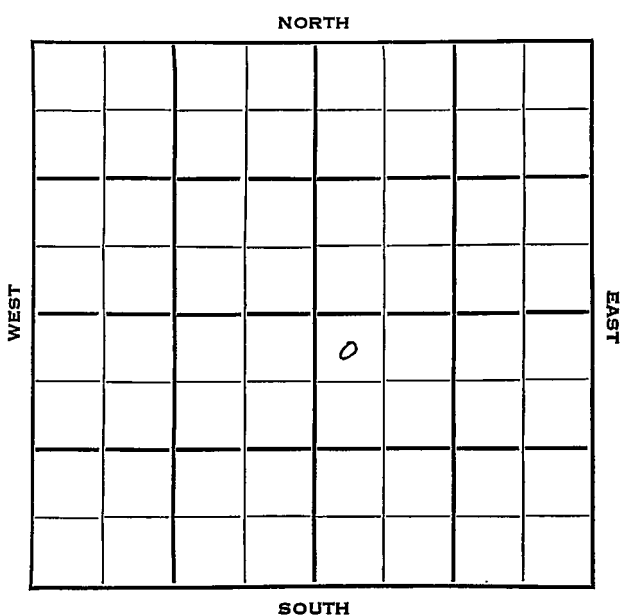

~~HOT FILE~~
FORM 12-522
No

Pawnee

KANSAS



Sec. 14 Twp. 21 R. 16 W

Well No. # 1 Wedel Farm

Carl Todd Company


Contractor

330 Ft. from N. Line

Ft. from S. Line

Ft. from E. Line

330 Ft. from W. Line

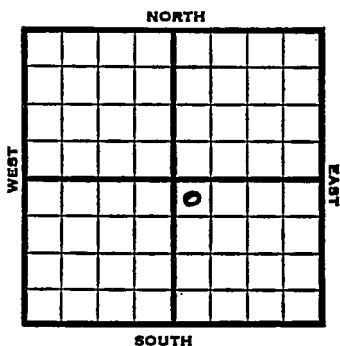


NW NW SE

MCPC has NE of 26

1953 Elev. 1973' REPORT

3/4	Location
3/12	Spudded 3-7-53 Set 8" @ 890 Drlg. 920' (Ltr)
3/19	Spudded 3-7-53 8" @ 890 Heeb 3356' Tor. 3373' Br lime 3449' Lans. 3459' Drlg. 3578' (Ltr)
3/26	Cong. 3735' Viola 3736' Simp 3799 Arb. 3837' DST 3835-40, open $\frac{1}{2}$ hr, rec 6' mud, 0# DST 3840-60, open 1 hr, rec 180' gas, 2550' muddy water, 1100# TD 3860' D & A (Ltr)
3/25	Spud 3-7-53 D&A TD 3860 8" @ 890 Heeb 3356, Tor 3373, Br lime 3449, Lans 3459, B KC 3694, Cong 3735, Viola 3736, Simp 3799, Arb. 3837 DST 3835-40, opn $\frac{1}{2}$ hrs., rec. 6' mud, 0# DST 3840-60, opn 1 hr., rec. 180' gas, 2550' muddy wtr 1100# D&A

ABANDONED

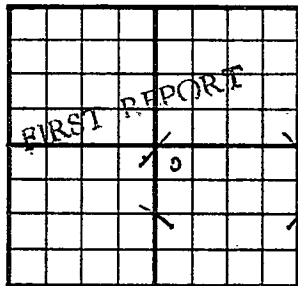County Pawnee State KansasSec. 14 (Blk.
Twp.) 21 (Sur.
Rge.) 16W Map No.Operator Carl ToddWell No. 1 Farm WedelElev. Location NW NW SE330 Ft. From N Line SE330 Ft. From W Line Quarter1st. Report MAR 4 1953

Completion

Remarks MCPC has NE of 26Todd - Contr.


Spudding Date

Drlg. Data

Location

J. G. McGEHEE

County Pawnee State Kansas
 Sec. 14 (Blk. 21) (Sur. 16W) Map No. 21
 Operator Carl Todd
 Well No. 1 Farm Wedel
 Elev. 1973 Location NW NW SE

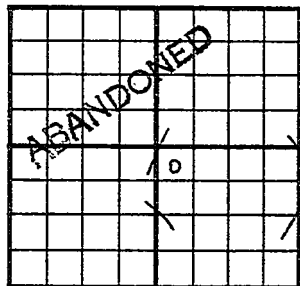330 Ft. From N Line SE330 Ft. From W Line Quarter

1st. Report

Completion MAR 25 1953

Remarks

Todd - Contr.Spudding Date 3-7-53Drlg. Data D & A TD 38608" @ 890 Heeb. 3356 Tor. 3373Br. lime 3449 Lans. 3459 B KC 3694Cong. 3735 Viola 3736 Simp. 3799Arb. 3837 DST 3835-40 open $\frac{1}{2}$ hr.Rec. 6' mud 0# DST 3840-60 open 1 hr.Rec. 180' gas 2550' muddy wtr. 1100#D & A