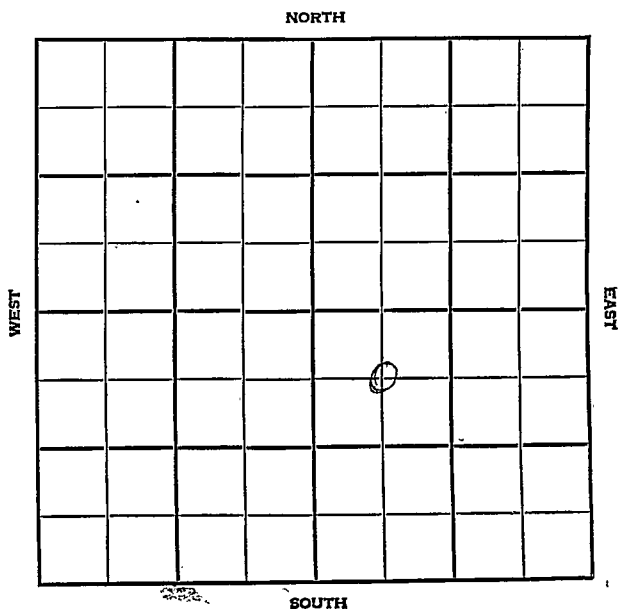


Section 14 Township 21 Range 24WWell No. #1 GoebelCompany H & H Drilg.

WILDCAT

FORM 513 SUNRAY

County Hodgeman Elev. _____
 Sec. 14 Twp. 21 Rgs. 24W
 Company H. & H. Drlg.
 FarmName Goebel No. 1

TOPS	DEPTH	LOG	DATUM	Loc. in Sec.
Anb.				C NW SE
Tr.				
H.				
Tr.				
Dg.				
BL.				
L.				
K.C.				Geol.
B.K.C.				Contr.
Ce.				Co. Tools
C.				
M.				
M.				Pool
K.				Wildcat
Mz.				
Mo.				
V.				
S.				
S.				
A.				
R.				
Pe.				
G.				
T.D.				

FIRST REPORT

Date Comm. spd. 11-11-56 Mag. AC Shell Ac & DHW
8" @ 245 w/175, Drlg. 1415


2761 C S 1011

15

FORM 513 SUNRAY

County Hodgeman Elev. 2392
 Sec. 14 Twp. 21 Rge. 24W
 Company H. & H. Drilg.
 FarmName Goebel No. 1

TOPS	DEPTH	LOG	DATUM	Loc. in Sec.
Ank.				C NW SE
TP.	3508			
H.	3853			
Tr.				
Dg.				
Bl.				
L.	3905	3905		Geol.
K.C.				Contr.
BXC. <u>Marm</u>	4300	4297		Co. Tools
Ce.				Pool
C.	4498	4498		Wildcat
M. <u>chat</u>	4507	4505		
M. <u>Dolo</u>	4527	4527		
K.	4675			
Mz.				
Mo.				
V.	4718	4738		
S.	4985	4985		
S.				
A.	5008	5007		
R.				
PE.				
G.				
TD.	5025			

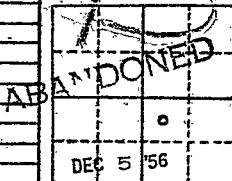

Date Comm. spd. 11-11-56 Mag. AC Shell Ac & DHM
 8" @ 245 W/175, Drilg. 1415 NOV 21 '56 3925

NOV 28 '56 X DST 4026-71 cor 1 hr 1160' SW
 FP 0-720 BHP 1300 120" DST 4316
 -31 cor 1 hr 1975' gas Rec 185
 MGCO BHP 1330 120" DST 4420-47
 cor 1 hr rec 20' Md BHP 0 120" 4485 4519 DEC 5 '56 DST 4504-21
 cor 30" 5' Md BHP 0 DST
 45.21-72 1 hr 50' HOCH & W

+ 250 oil E Wt (2090 oil)
+ 120' Wt FP 0-220 BHP
1280 DST 4536-47 In 490' SW
FP 140-220 BHP 760/20"

DEA